


DATE _____

TOWN OF LEXINGTON — BOARD OF PUBLIC WORKS
SEWER DIVISION

Sketch of Service Here

6

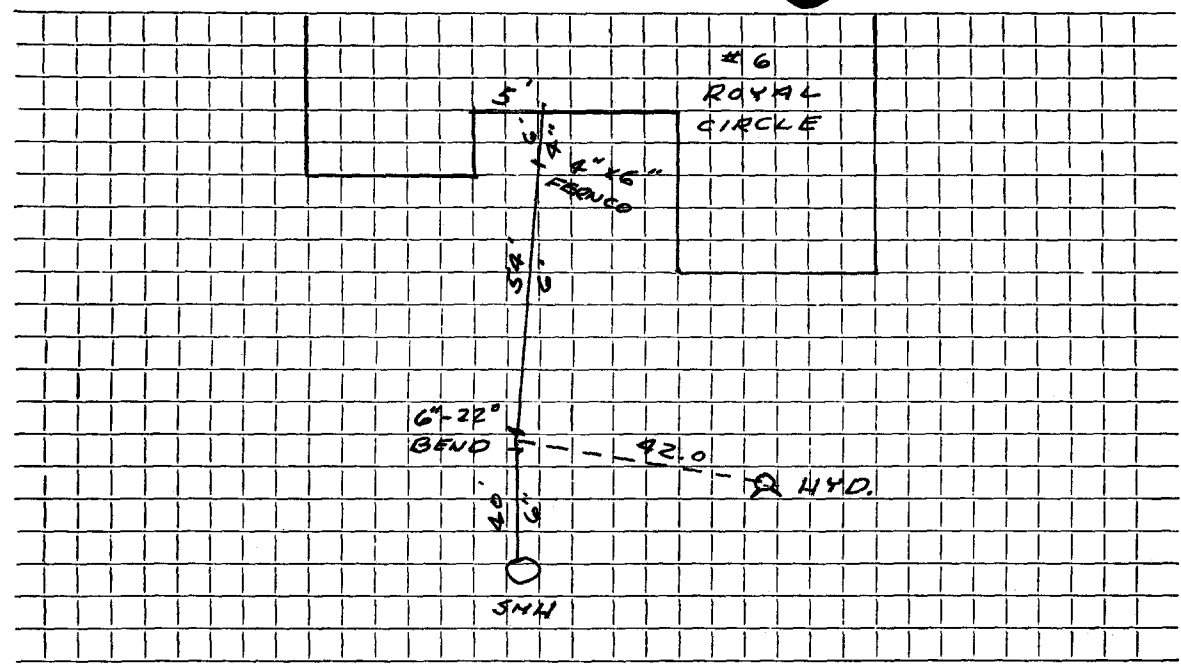

Connection made in ROYAL CIRCLE Street. Work completed

Remarks: MCLAUGHLIN CONTR. I. S.
REDMOND CONTR. O. S.