

Name

Barry Couette

Service No.

Address

7 Royal Circle

7 Royal Circle

Location

Kind of Pipe

Size 6"

Size of Main 8"

Repair—Renewal—New Service

McKong/14 # 0279

Location

Date

Material

Amount

Total

Date

Amount

9/21/93

8 LF 4" PVC

104 LF 6" PVC


SMH PRE-CAST

4'x6" FERNID

DATE 1/9/93

TOWN OF LEXINGTON — BOARD OF PUBLIC WORKS
SEWER DIVISION

Sketch of Service Here 7

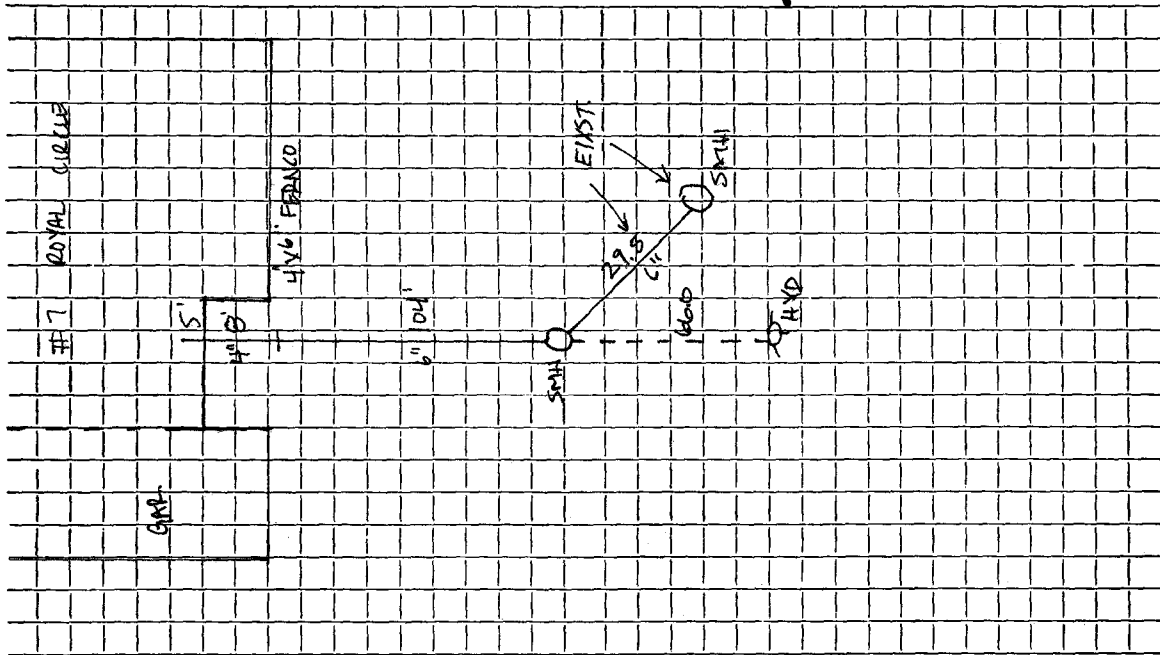

Connection made in Street. Work completed .. 2/21/93 .. J. McLAUGHLIN

Remarks:
.....
.....