




DATE 8-10-74

TOWN OF LEXINGTON — BOARD OF PUBLIC WORKS  
SEWER DIVISION

Sketch of Service Here **10**

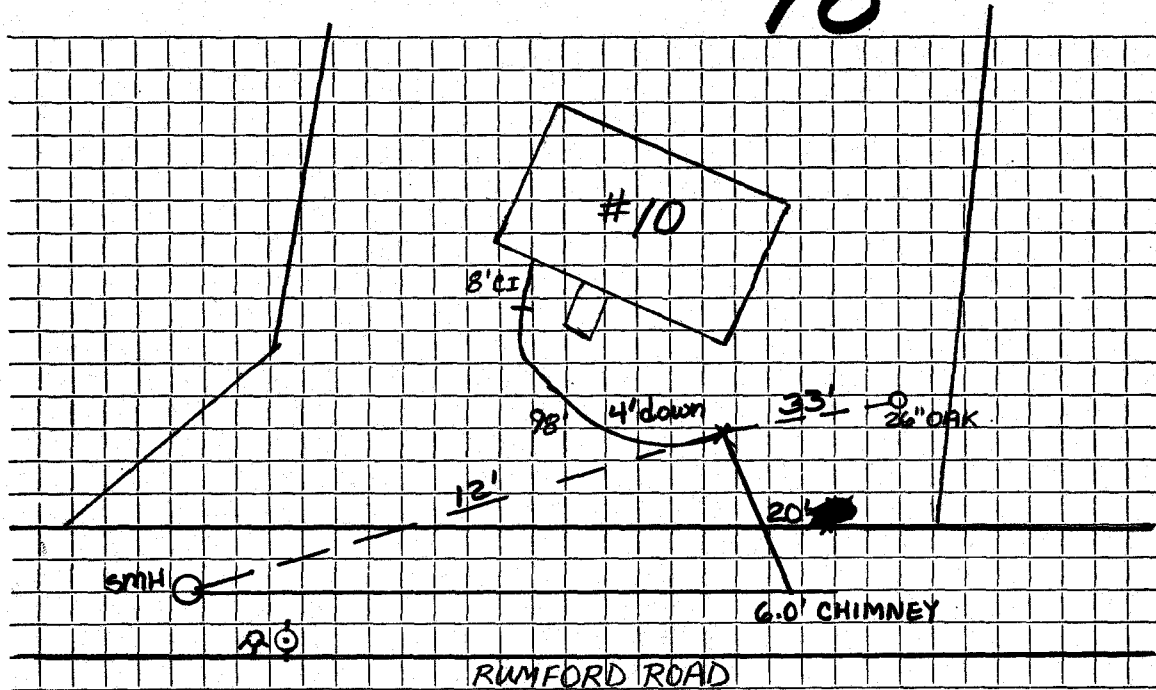

Connection made in RUMFORD ROAD Street. Work completed 9-30-74

Remarks: .....