


DATE B-10-74

TOWN OF LEXINGTON — BOARD OF PUBLIC WORKS
SEWER DIVISION

Sketch of Service Here **13**

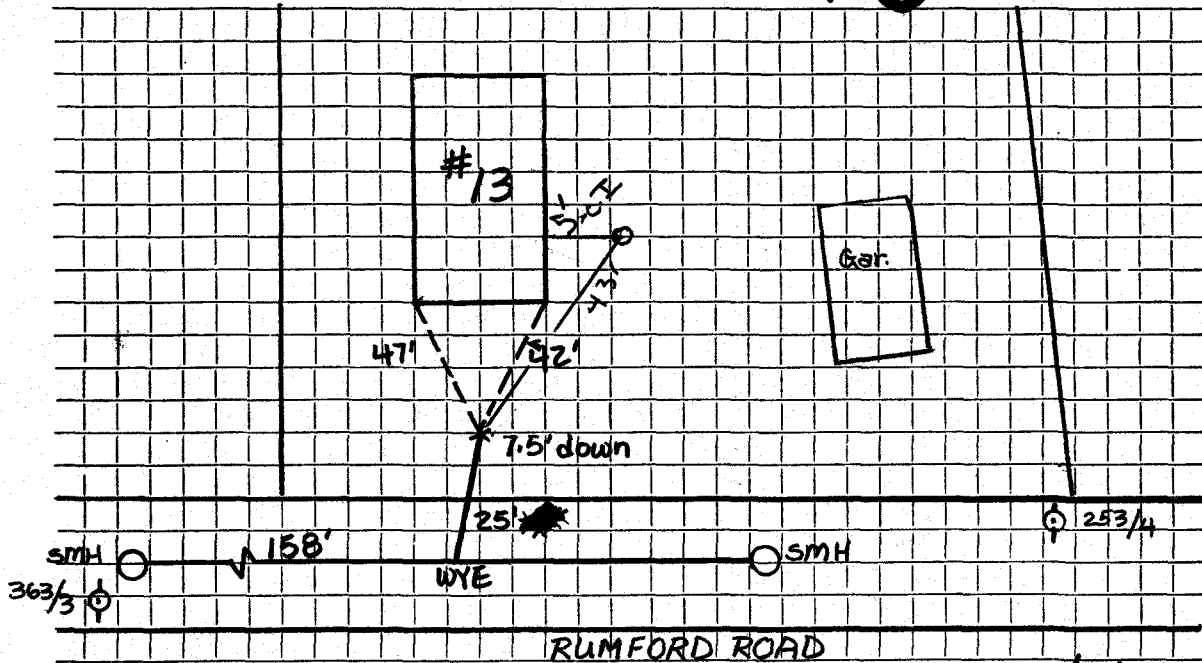

Connection made in #13 Rumford St Street. Work completed 10/9/74

Remarks:

.....

.....