




DATE \_\_\_\_\_

TOWN OF LEXINGTON — BOARD OF PUBLIC WORKS

SEWER DIVISION

Sketch of Service Here

14

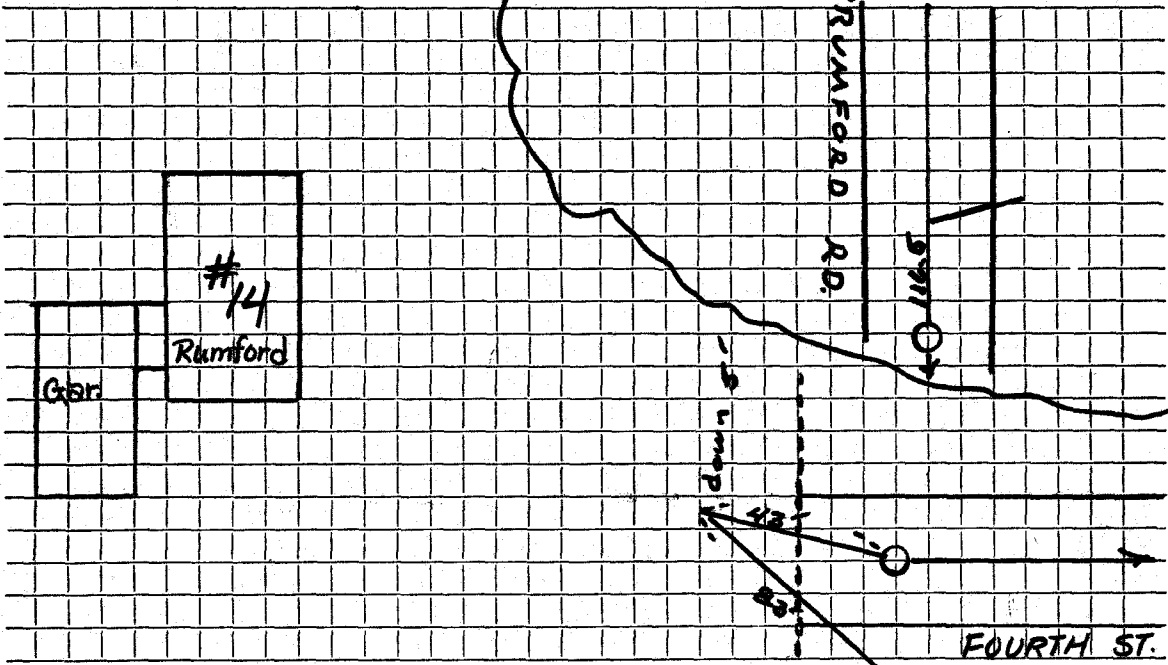

#14

Connection made in ..... Street. Work completed .....

Remarks: .....

.....

.....