




DATE 8-10-74

TOWN OF LEXINGTON — BOARD OF PUBLIC WORKS  
SEWER DIVISION

Sketch of Service Here **15**

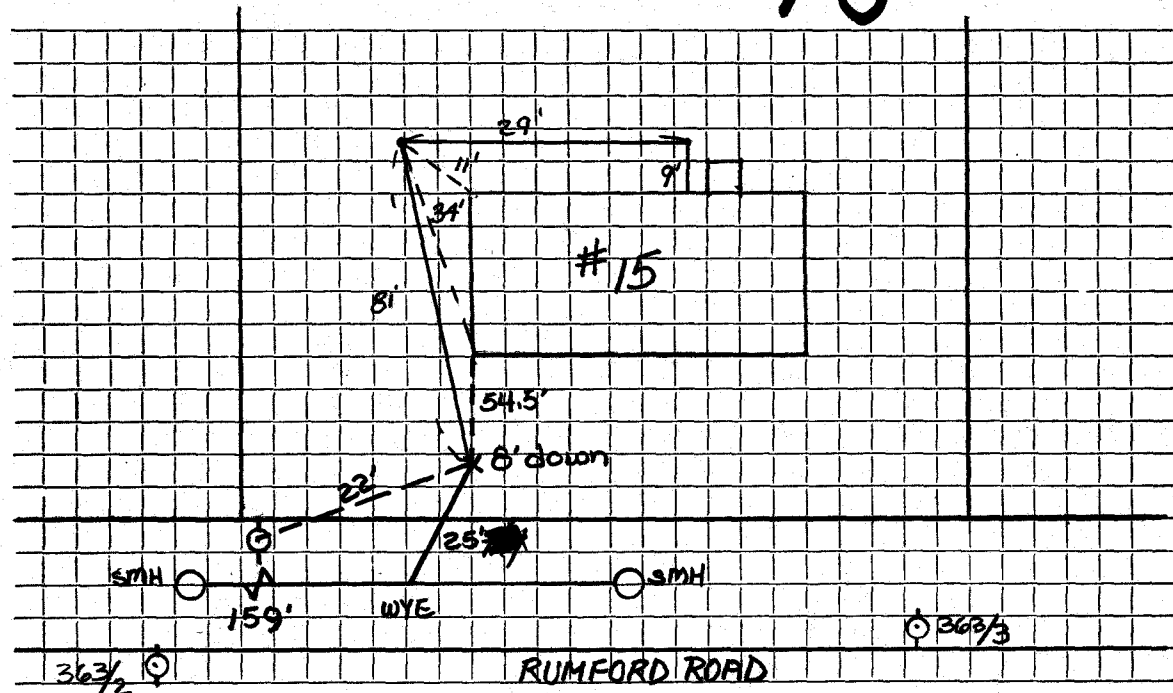

Connection made in RUMFORD ROAD Street. Work completed OCTOBER 7, 1974

Remarks: .....

.....

.....