


DATE 8-10-74

TOWN OF LEXINGTON — BOARD OF PUBLIC WORKS
SEWER DIVISION

Sketch of Service Here **16**

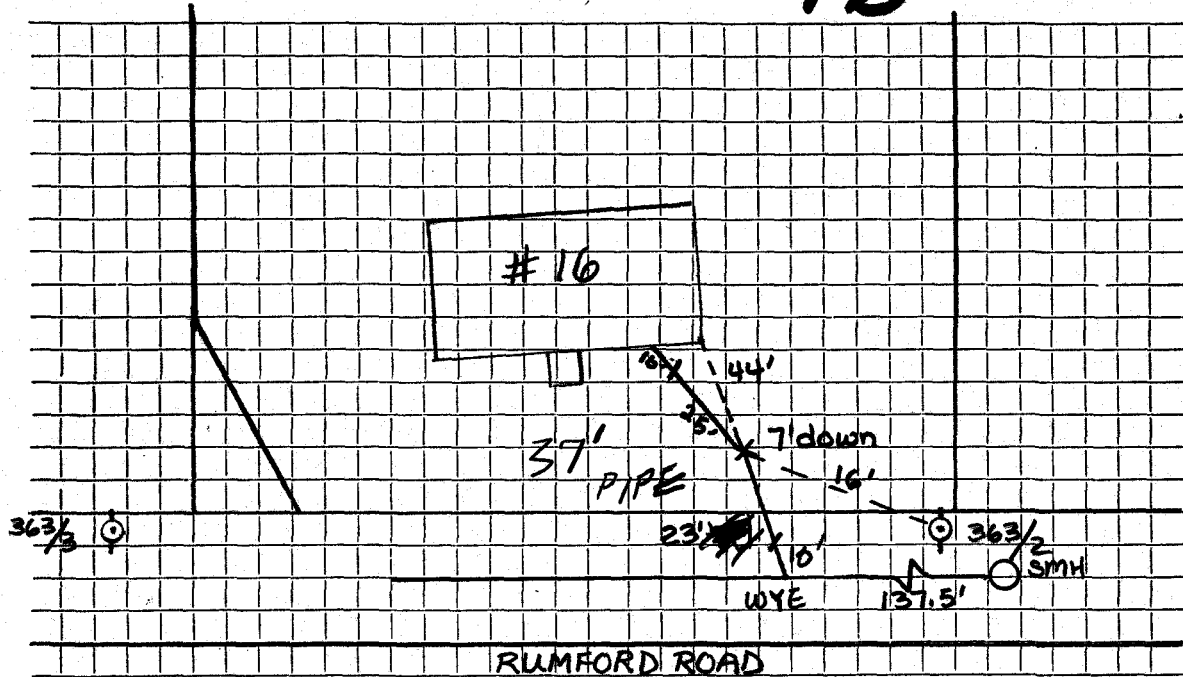

Connection made in #16 Rumford Rd. Street.

Work completed 10/1/74

Remarks:

.....

.....