

Name Richard D. Gilman

011
Service No. 57. (74)

Address #17 Rumford Road

17 Rumford Road

Location

Kind of Pipe A.C

Size 6" A.C

Size of Main 8"

Repair—Renewal—New Service Valeri #2412

Location AUG 16 1976

Date	Material	Amount	Total	Date	Amount
8-10	74 23' 23'	9.00 ft.	207.00	9/10/74	207.00
1/23/74	130' 6" Transite Pipe			Deposit	


B.N. 1801

DATE 8-10-74

TOWN OF LEXINGTON — BOARD OF PUBLIC WORKS
SEWER DIVISION

Sketch of Service Here

17

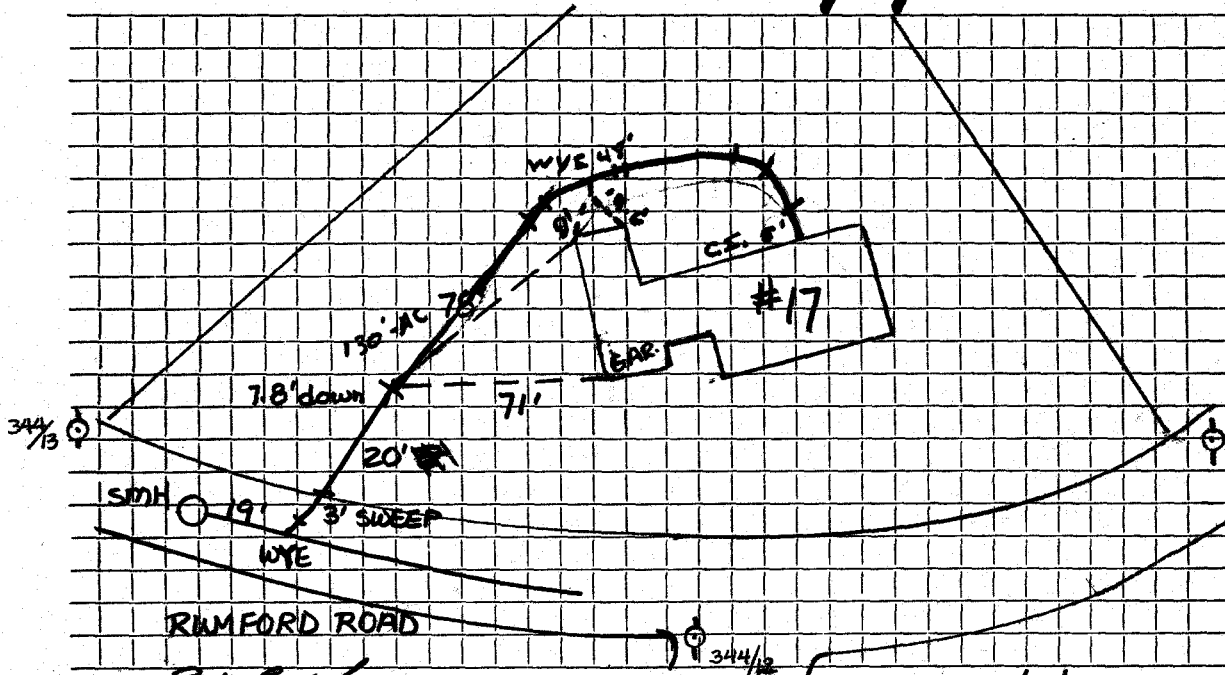

Connection made in PUMFORD ~~10. W. ST.~~ Street. Work completed 8/10/74

Remarks:

.....

.....