

Name

Address #4 Rumford Road

4 Rumford Road

Kind of Pipe

Size 6" A.C.

Size of Main 8"

Repair—Renewal—New Service

Location

Location

Service No.

Amount

Date

Material

Amount

Date

225.00

9.00

91.

July 22 1974 25' 2"


DATE JULY 22, 1974

TOWN OF LEXINGTON — BOARD OF PUBLIC WORKS

SEWER DIVISION

Sketch of Service Here

4

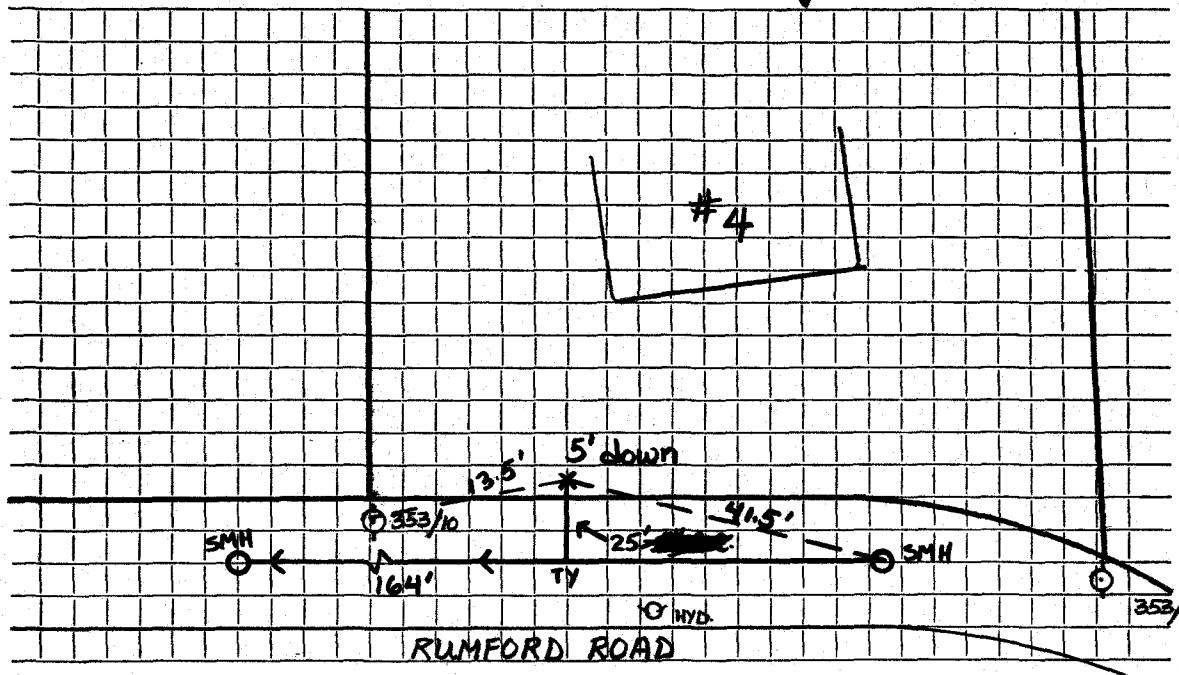

Connection made in Street. Work completed

Remarks: