

OK
Service No.

Name

Address #6 Runnford Road

6 Runnford Road

Location

Kind of Pipe

Size 6" A.C.

Size of Main 8"

Repair—Renewal—New Service

Location


Date	Material	Amount	Total	Date	Amount
July 22 1974	20' XXXXX	9.00 ft.	100.00 XXXXX		

DATE 10-3-00

TOWN OF LEXINGTON — BOARD OF PUBLIC WORKS

SEWER DIVISION

Sketch of Service Here

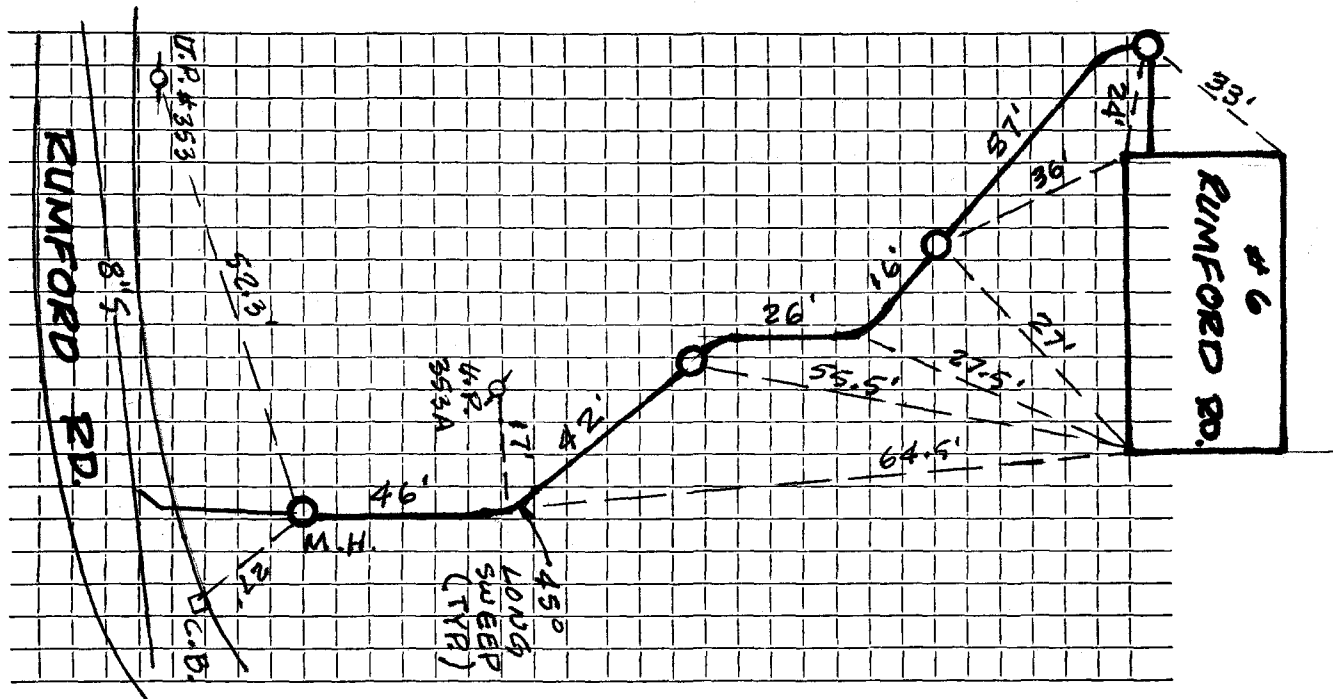

Connection made in Street. Work completed


Remarks: INSTALLED BY GREENWOOD & SON
INSPECTED BY PETER KARALEXIS

DATE July 22, 1974

TOWN OF LEXINGTON — BOARD OF PUBLIC WORKS
SEWER DIVISION

Sketch of Service Here

6

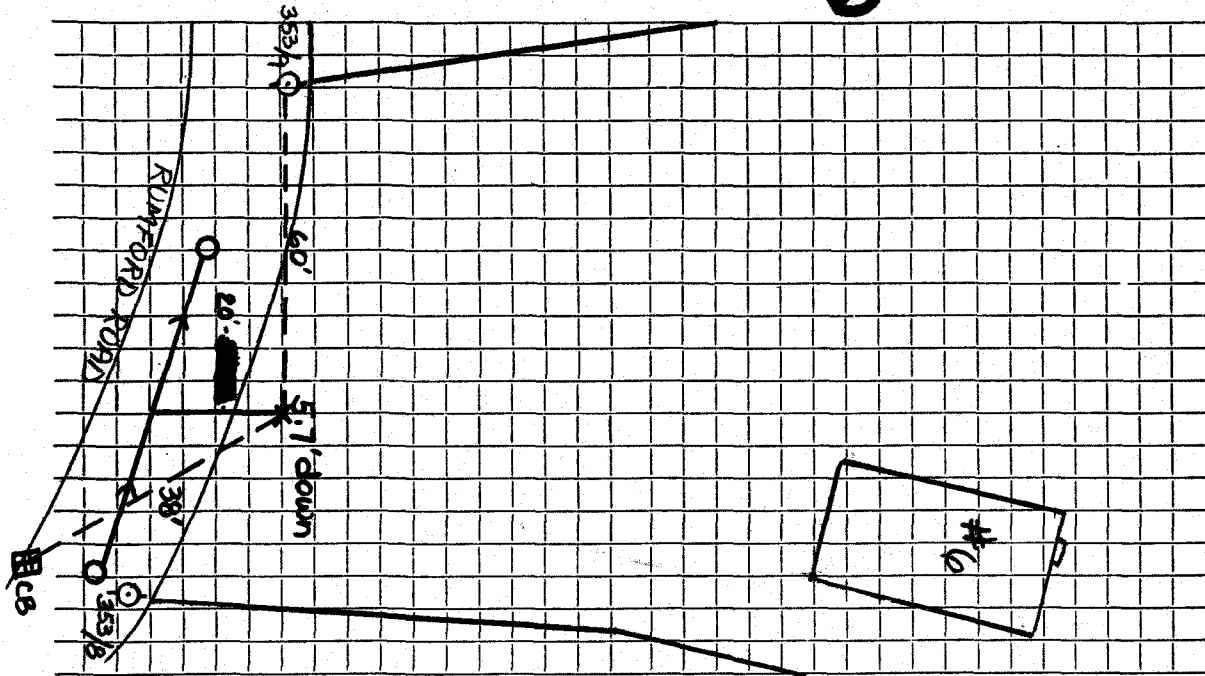

Connection made in Street. Work completed

Remarks:
.....
.....