


DATE _____

TOWN OF LEXINGTON — BOARD OF PUBLIC WORKS

SEWER DIVISION

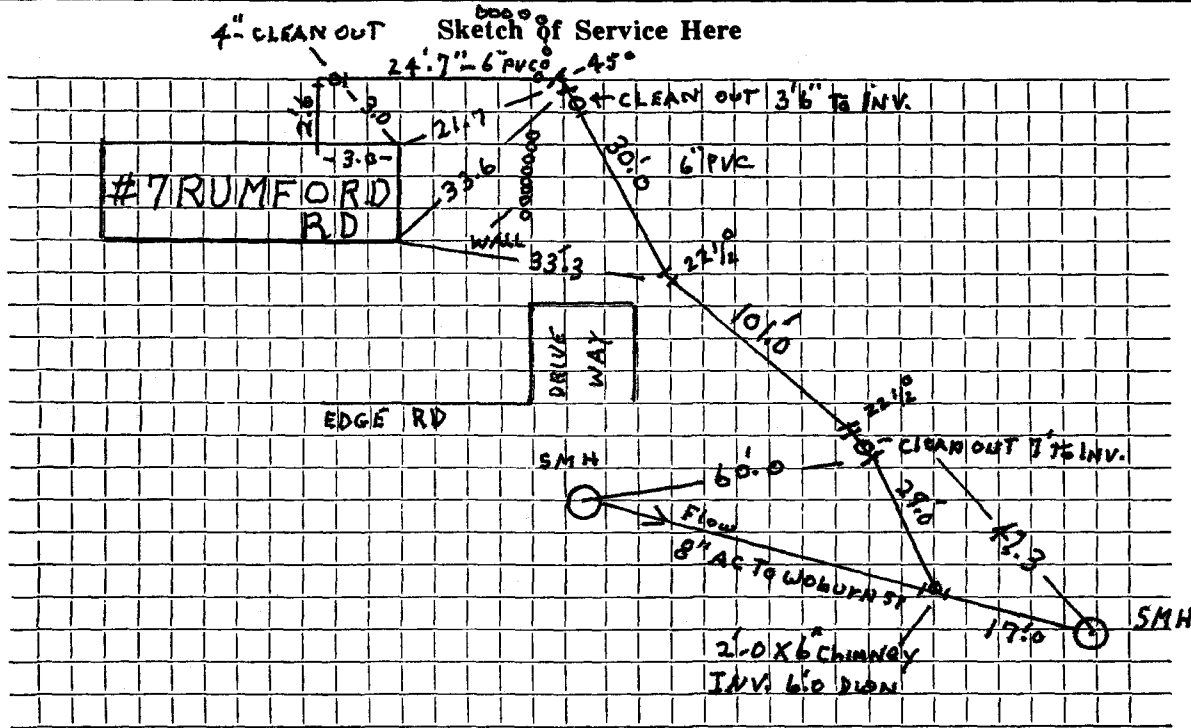

Connection made in Street. Work completed July 15, 2003

Remarks: 1000 GAL TANK Pumped & Filled In