


DATE July 22, 1974

TOWN OF LEXINGTON — BOARD OF PUBLIC WORKS
SEWER DIVISION

Sketch of Service Here

8

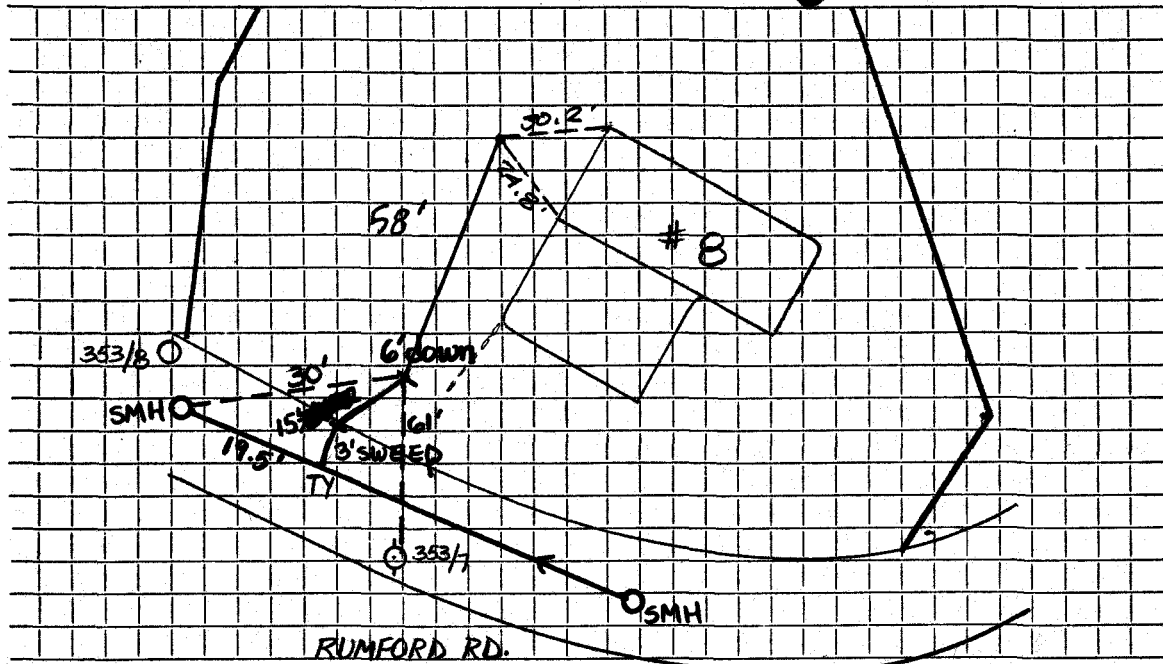

Connection made in RUMFORD ROAD Street. Work completed 10-1-74

Remarks:

.....

.....