




DATE \_\_\_\_\_

TOWN OF LEXINGTON — BOARD OF PUBLIC WORKS  
SEWER DIVISION

Sketch of Service Here

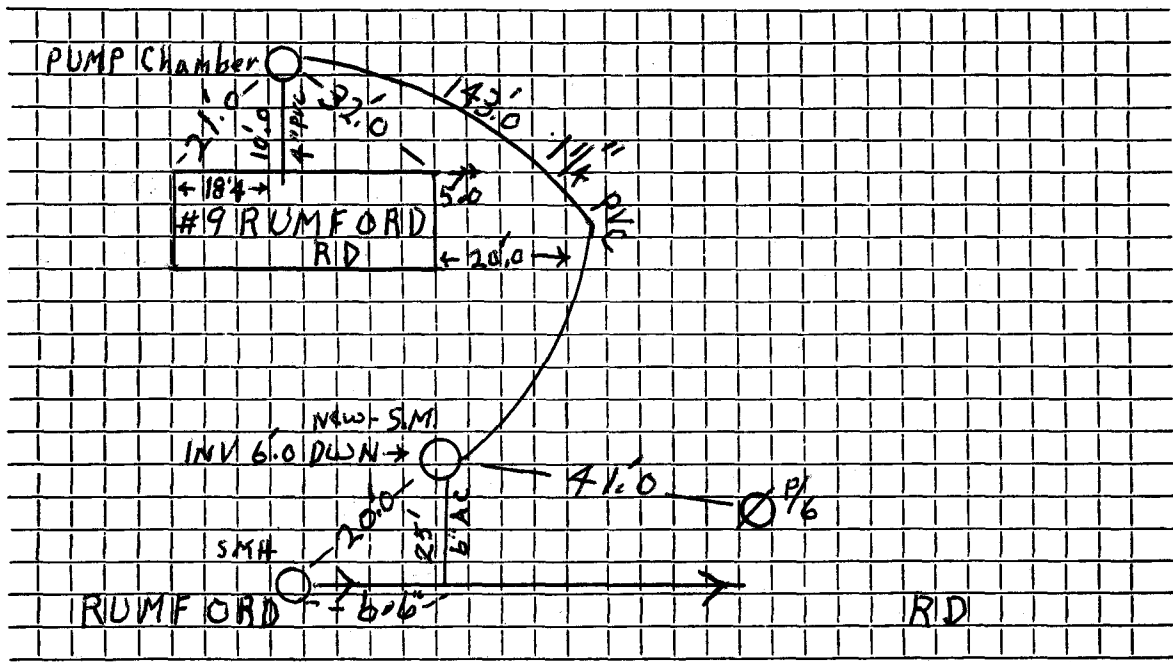

Connection made in Rumford R.D. Street.

Work completed 10/19/06 J. McLaughlin

Remarks: .....