

Name *Marissa Liggiero (Insp.)*

Service No.

Address *10 Russell Rd*

Contractor: *JM McLaughlin*

Location

Kind of Pipe *6" PVC SDR35* Size

Size of Main

Repair—Renewal—New Service


Location

Date	Material	Amount	Total	Date	Amount
<i>5/11/18</i>	<i>HOME to MAIN</i>				
	<i>4x6" FERNCO</i>				
	<i>6" Cleanout</i>				
	<i>6" PVC Pipe</i>	<i>10'</i>			
	<i>22 1/2° BEND</i>				
	<i>6" PVC Pipe</i>	<i>8'</i>			
	<i>22 1/2° BEND</i>				
	<i>6" PVC Pipe</i>	<i>24'</i>			
	<i>NEW 6" TIE IN</i>				
	<i>DEPTH = 7'6"</i>				

DATE 5/11/18

TOWN OF LEXINGTON — BOARD OF PUBLIC WORKS
SEWER DIVISION

Sketch of Service Here

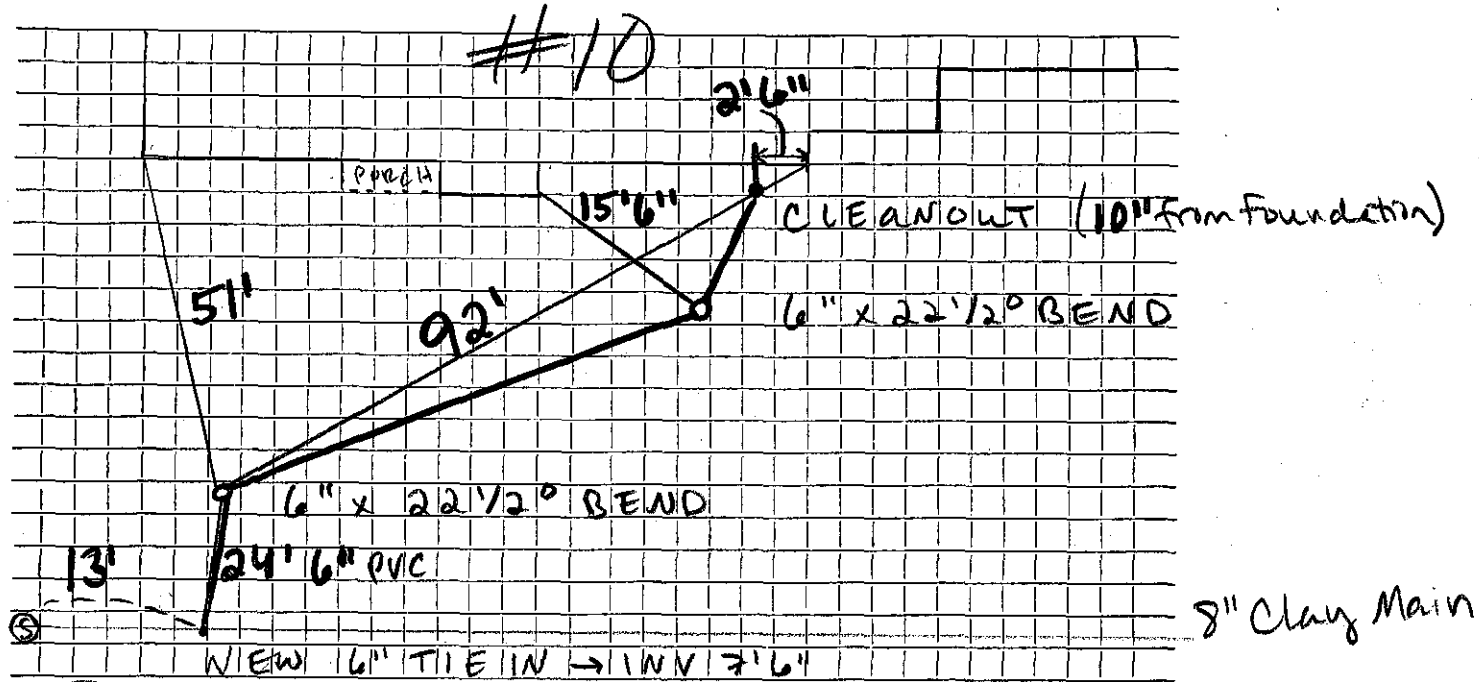

Connection made in ... Russell Rd Street.

Work completed

Remarks: taken from JM McLaughlin's Tick