

Name Norton G. Zaiff

Service No.

Address 6 Russell Road

6 Russell Road

Location

Kind of Pipe

Size 6"

Size of Main 8"

Repair ~~Renewal~~ New Service

Location

| Date | Material | Amount | Total | Date | Amount |
|---------|---------------------------|--------|--------|----------|--------------------------------------|
| 10-9-58 | Labor | 85.10 | 85.10 | | |
| | 50' 6" Transite pipe @.70 | | 35.00 | | |
| | 5 hrs. Town Shovel @ 6.50 | | 32.50 | | |
| | 3 hrs. Trucking @.75 | | 2.25 | | |
| | | | 154.85 | 12/31/84 | |
| | | | | 25' | 6" PVC |
| | | | | 2' | 8" PVC |
| | | | | 1 | 8x8x6 PVC Tee |
| | | | | 1 | 6" PVC 90° Elbow |
| | | | | 2 | 8" Clay to PVC Fernco |
| | | | | 1 | 6" PVC to Trans Fernco Patch |
| | | | | | Had Roto matic 4 times / 80' out |
| | | | | | Response to next call |
| | Labor | | | | find out where p-up is JW |
| | | | | 12-11-84 | Roots 80' out |
| | | | | 11-22-91 | Roots 48' out |
| | | | | 3-25-05 | problem in MAIN 200' up from MH # 26 |

TOWN OF LEXINGTON—DEPT. OF PUBLIC WORKS

SEWER DIVISION

DATE.....


NO.

The undersigned applies for the construction of a particular sewer connecting No.....
 Street and hereby agrees to comply with the Rules and Regulations governing the construction and use of Particular
 Sewers, as now or at any future time established by the Board of Selectmen.

Am't of estimate \$.....

Am't Paid \$.....

6 RUSSELL RD
 [Redacted Box] Owner

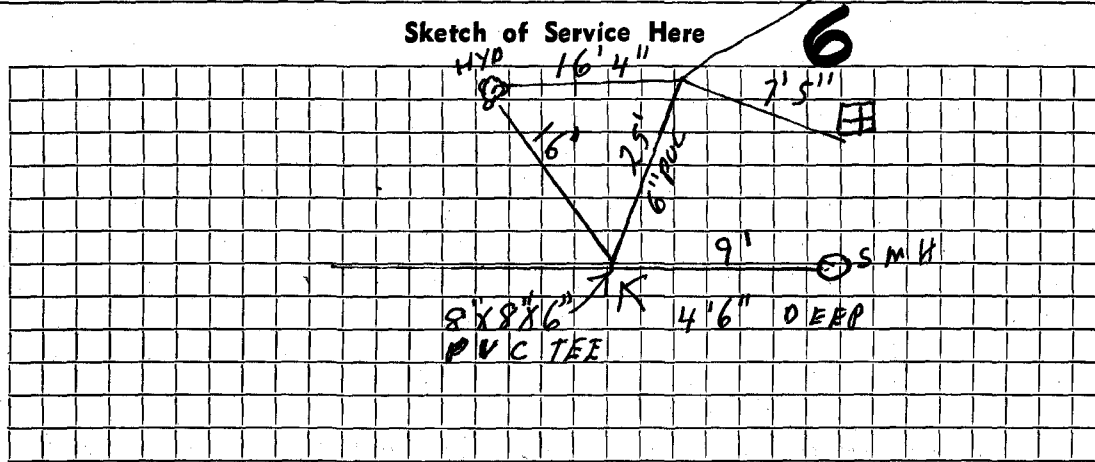

Connection made in..... Street.

Work completed.....19..

Remarks: