

Name B. Ray Carlson

Service No.

Address 3 Ryder Lane Lot 23

3 Ryder Lane

Location

Kind of Pipe

Size 6"

Size of Main 8"

Repair—Renewal—New Service

DeFlice Bros. #3456

Location


Date	Material	Amount	Total	Date	Amount
7/27/79	28' 6" Transit Pipe				
	10' 4" Cast Iron Pipe				

DATE _____

TOWN OF LEXINGTON — BOARD OF PUBLIC WORKS

SEWER DIVISION

Sketch of Service Here **3**

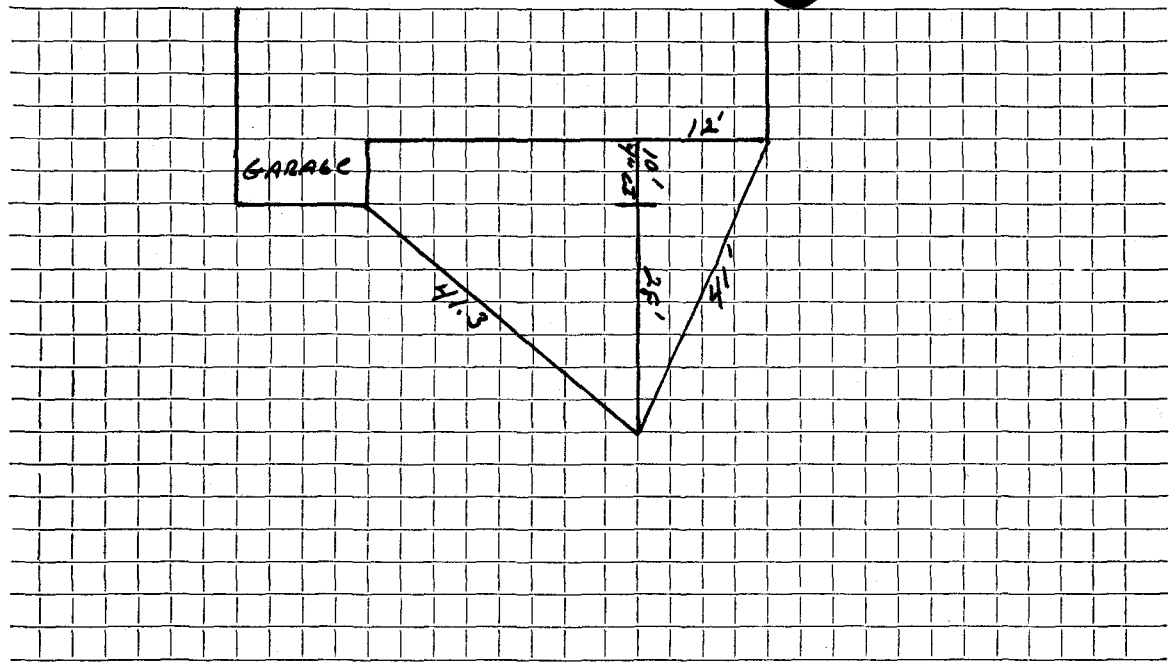

Connection made in Street. Work completed

Remarks:
.....
.....