


DATE _____

TOWN OF LEXINGTON — BOARD OF PUBLIC WORKS
SEWER DIVISION

Sketch of Service Here
6

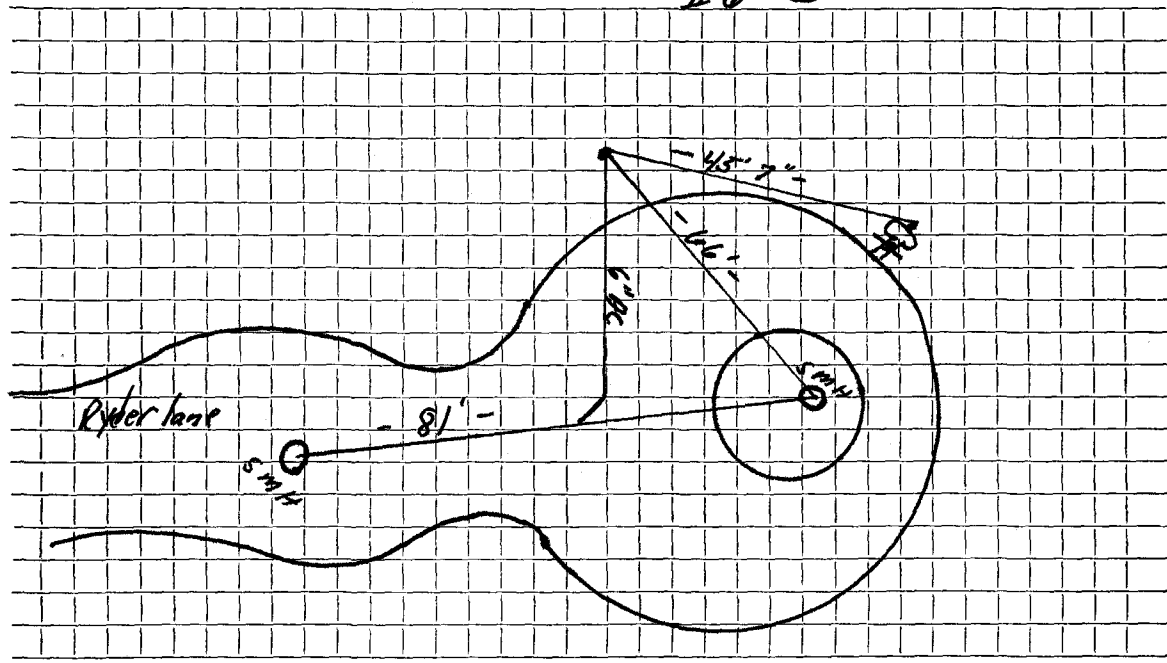

Connection made in Street. Work completed

Remarks: Connected But Not Inspected By Sewer Division

.....
.....