

Name Irving Belansky

Service No. 71

Address 10 SADDLE CLUB RD.

Location

Kind of Pipe A.C.

Size 6"

Size of Main 10"

Repair—Renewal—New Service Valeri #3101

Location NOV 19 1973


Date	Material	Amount	Total	Date	Amount	
7/9/73	26'-6" A.C. @ 8.90	\$231.40		7-23-73	Deposit	231.40
7/24/73	37' 6" Transite pipe					

DATE _____

TOWN OF LEXINGTON — BOARD OF PUBLIC WORKS

SEWER DIVISION

Sketch of Service Here **10**

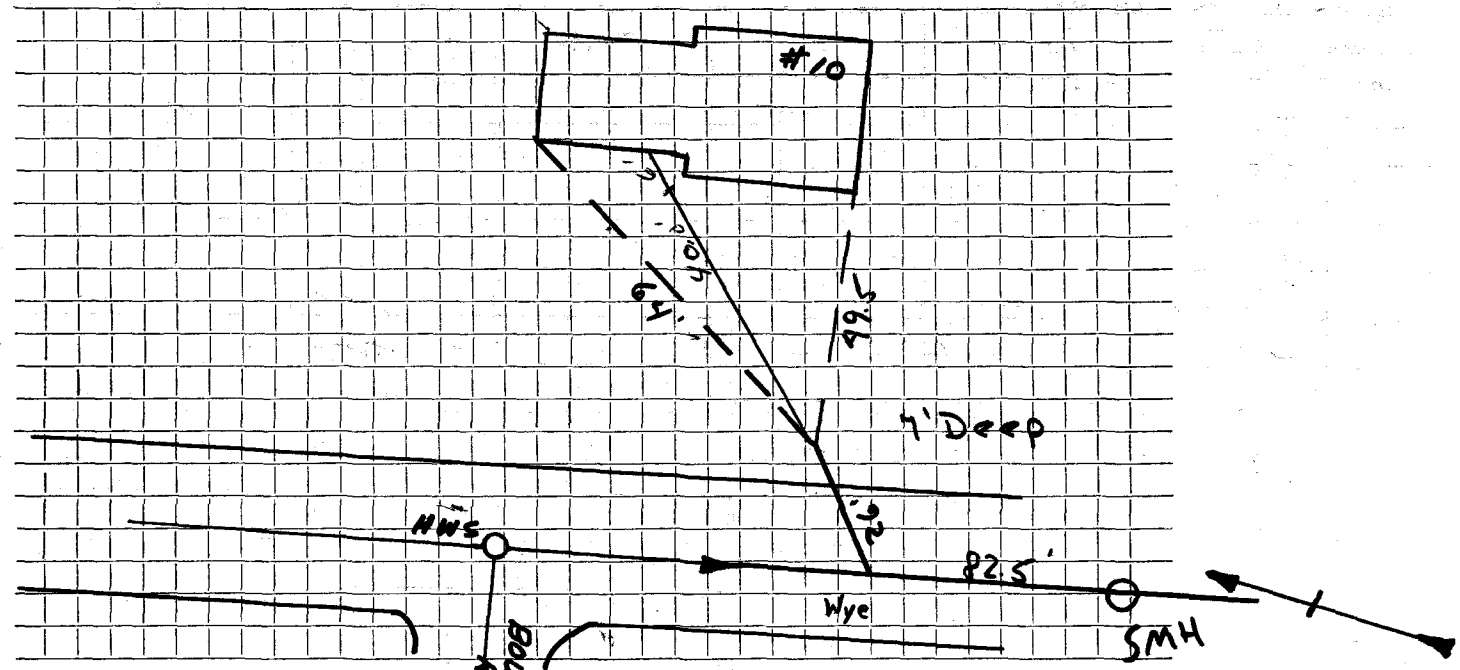

Connection made in Street. Work completed

Remarks:
.....
.....