


DATE July 9, 1973

TOWN OF LEXINGTON — BOARD OF PUBLIC WORKS

SEWER DIVISION

Sketch of Service Here **11**

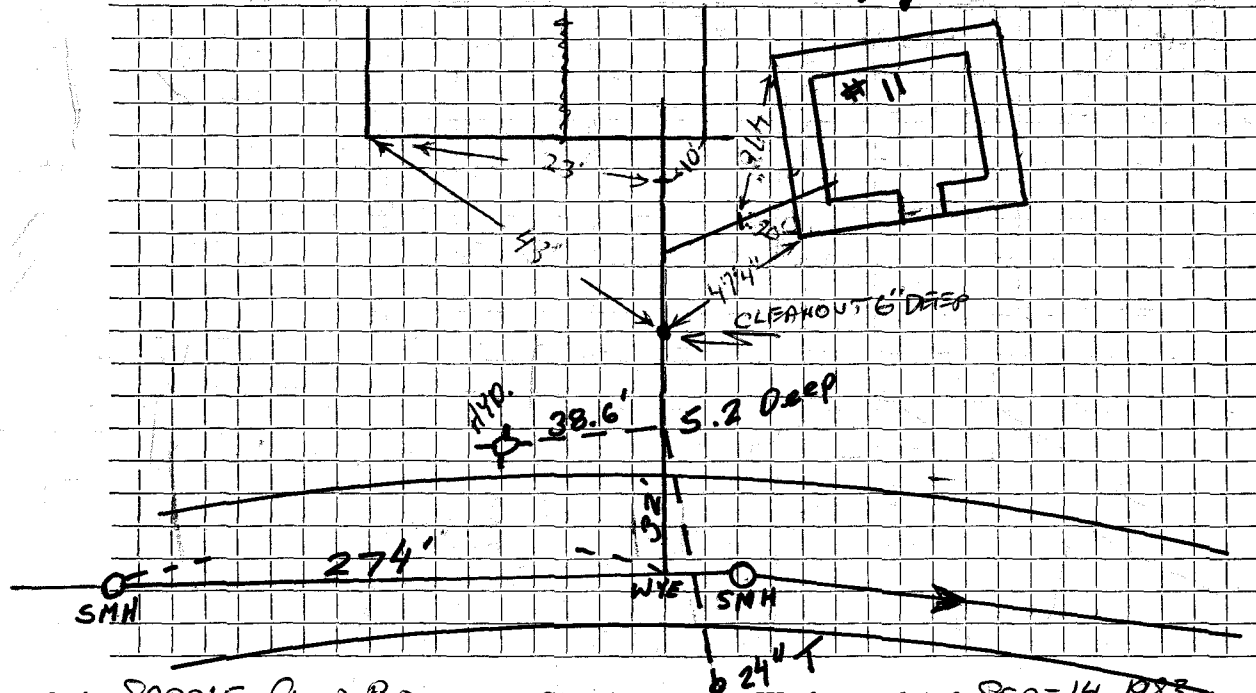

Connection made in SADDLE CREEK RD. Street.

Work completed SEP. 14, 1983

Remarks: TWO HOUSES INTO ONE SERVICE (GARAGE?)