

Name Pramod Soparkar

Service No.

145

Address 12 SADDLE CLUB

Location

Kind of Pipe A.C.

Size 6"

Size of Main 10"

Repair—Renewal—New Service

Valeri #2412

Location AUG 16 1976

Date	Material	Amount	Total	Date	Amount
7/9/73	22'-6" A.C. @ \$8.90	\$195.80		10/17/73	Deposit 195.80
10/26/73	131' 6" Transite Pipe				
	10' 4" Cast Iron Pipe				


B.M. 18501

DATE _____

TOWN OF LEXINGTON — BOARD OF PUBLIC WORKS

SEWER DIVISION

Sketch of Service Here **12**

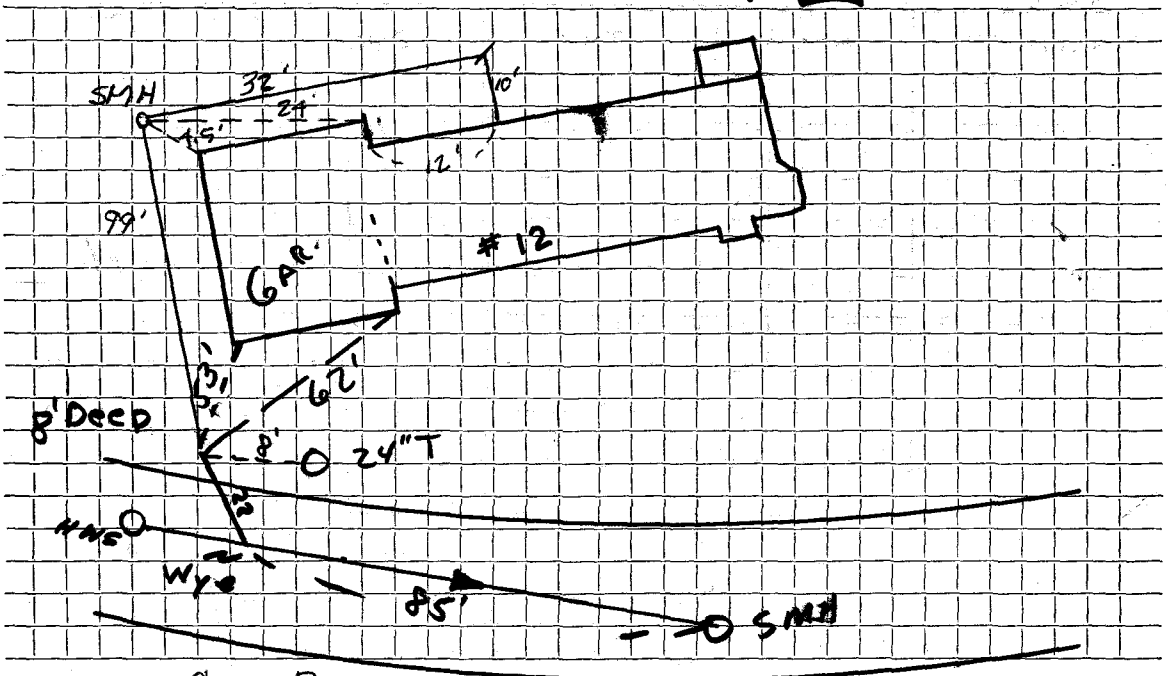

Connection made in SADDLE CLUB ROAD Street. Work completed ... 10-26-73

Remarks:
.....
.....