

Name

Service No.

Address **14 SADDLE CLUB RD.**

Location

Kind of Pipe **A.C.**

Size **6"**

Size of Main ~~8"~~ **10"**

Repair—Renewal—New Service

Location

Date	Material	Amount	Total	Date	Amount
7/9/73	25'-6" A.C. @ 18.90	\$ 222.50			


DATE _____

TOWN OF LEXINGTON — BOARD OF PUBLIC WORKS

SEWER DIVISION

Sketch of Service Here

14

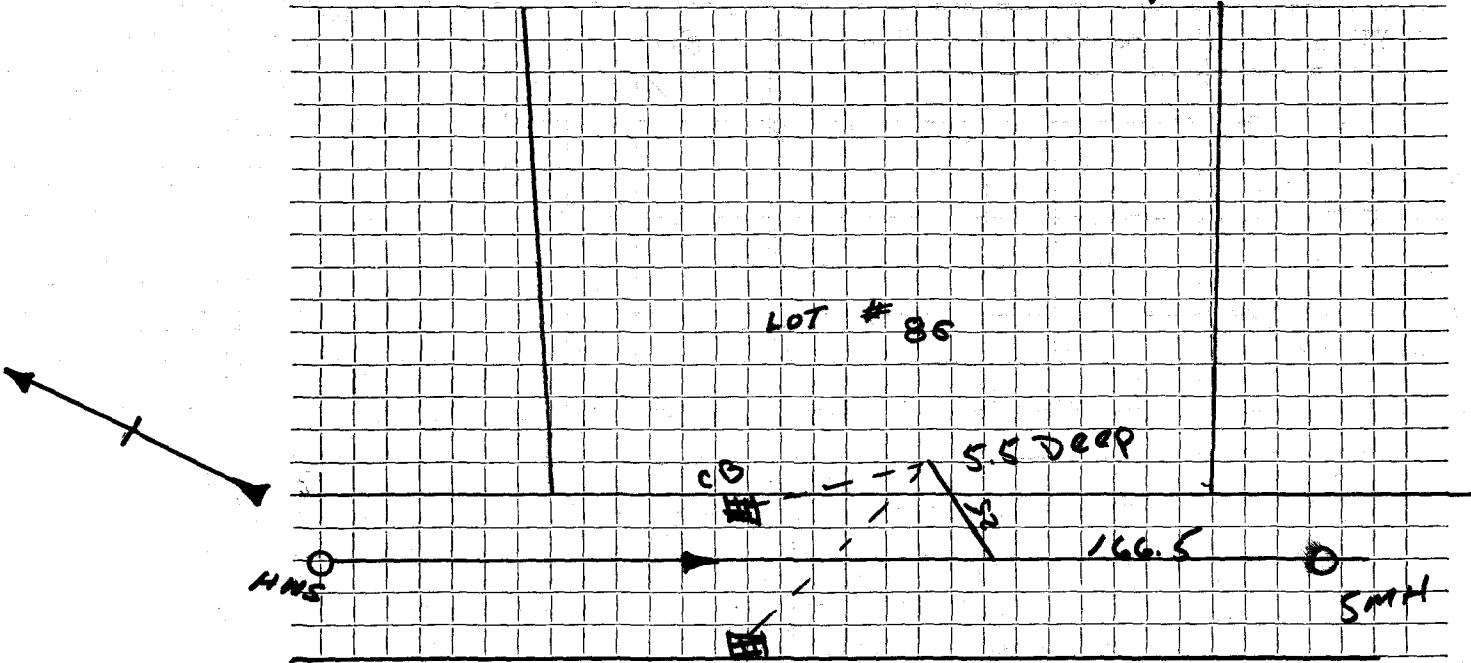

Connection made in Street. Work completed

Remarks:

.....

.....