




DATE \_\_\_\_\_

TOWN OF LEXINGTON — BOARD OF PUBLIC WORKS  
SEWER DIVISION

Sketch of Service Here

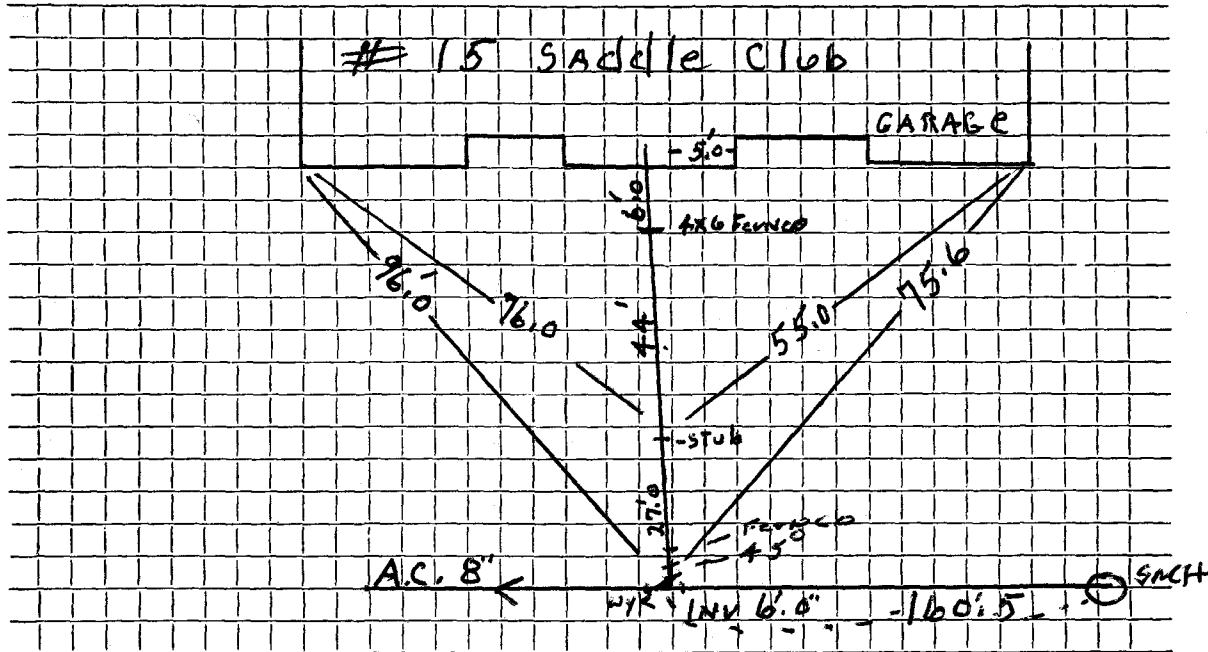

Connection made in ..... Street. Work completed 7/8/04 J. McCaughran

Remarks: WENT TO MAIN TO LOWER SERVICE.....

.....

.....