


DATE 8/26/2020

TOWN OF LEXINGTON — BOARD OF PUBLIC WORKS
SEWER DIVISION

Sketch of Service Here

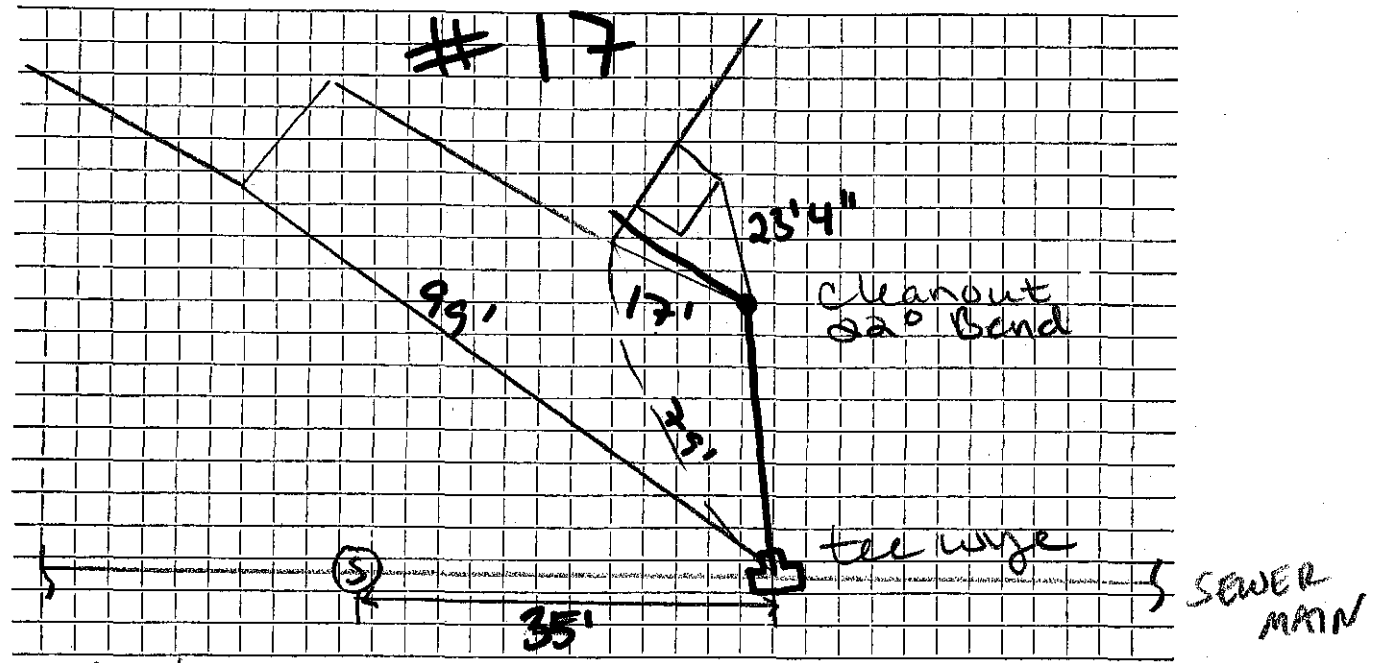

Connection made in ... Saddle Club Rd Street Work completed

Remarks:
.....
.....