
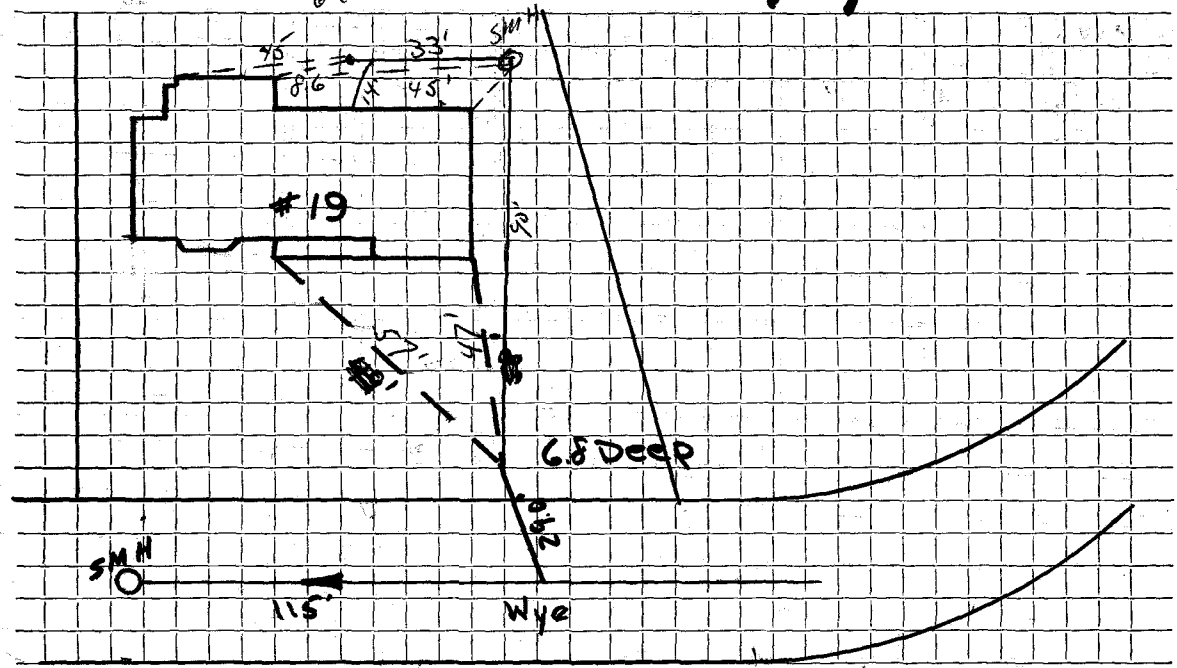


DATE _____

TOWN OF LEXINGTON — BOARD OF PUBLIC WORKS

SEWER DIVISION

Wye
6" CLEAR out Sketch of Service Here **19**

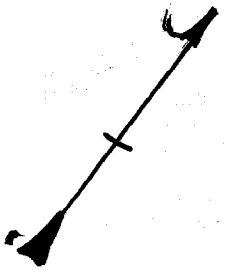

Connection made in Street. Work completed

Remarks:
.....
.....