

Name **Simmons Lessell, M.D.**

Service No. **66**

Address **20 SADDLE CLUB RD**

Location

Kind of Pipe **A.C.**

Size **6"**

Size of Main **10"**

Repair—Renewal—New Service **Ferrari #2298**


Location **NOV 19 1973**

Date	Material	Amount	Total	Date	Amount	
7/9/73	28'-6" A.C. @ \$8.90	\$249.20		7-10-73	Deposit	249.20
7/20/73	35' 6" Transite pipe					
	10' 4" Cast Iron pipe					

DATE \_\_\_\_\_

TOWN OF LEXINGTON — BOARD OF PUBLIC WORKS  
SEWER DIVISION

Sketch of Service Here **20**

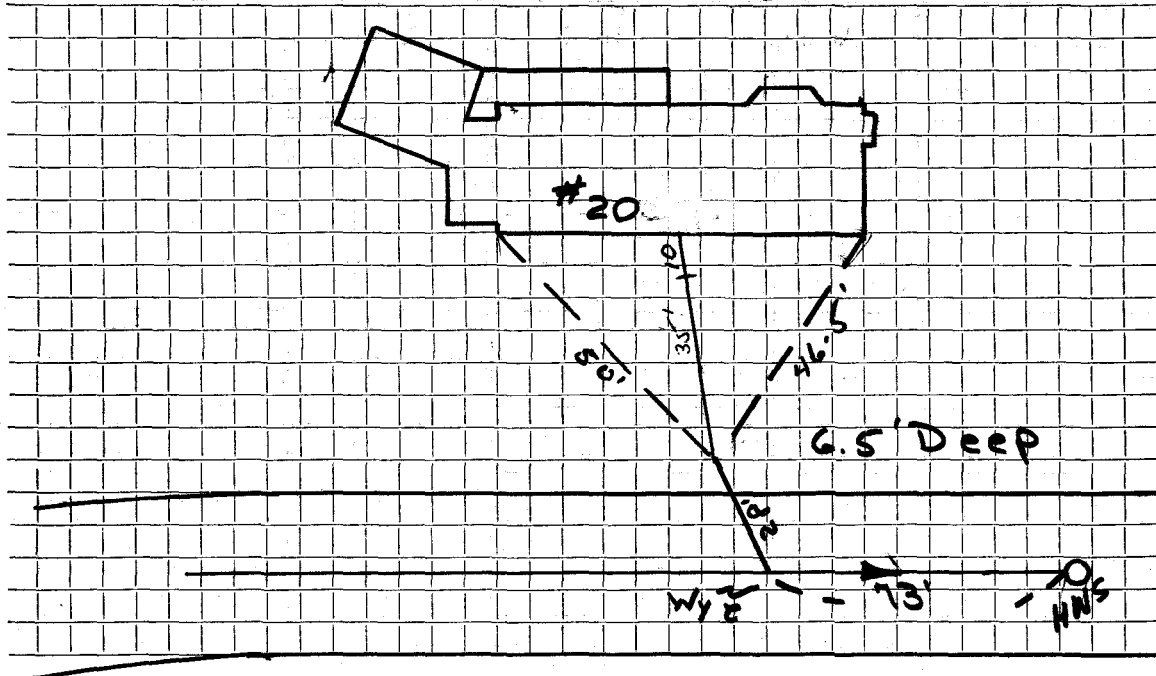

Connection made in ..... Street. Work completed .....

Remarks: .....  
.....  
.....