

Name Richard John Sr.

Service No. 68

Address 21 SADDLE CLUB RD

Location

Kind of Pipe A.C.

Size 6"

Size of Main 10"

Repair—Renewal—New Service Valeri #2300

Location NOV 19 1973

Date		Material	Amount	Total	Date		Amount
7/9/73		29' 6" A.C. @ \$8.90	\$ 258.10		7-30-73	Deposit	258.10
7/24/73	40'	6" Transite pipe					
	10'	4" Cast Iron pipe					



DATE _____

TOWN OF LEXINGTON — BOARD OF PUBLIC WORKS

SEWER DIVISION

Sketch of Service Here

21

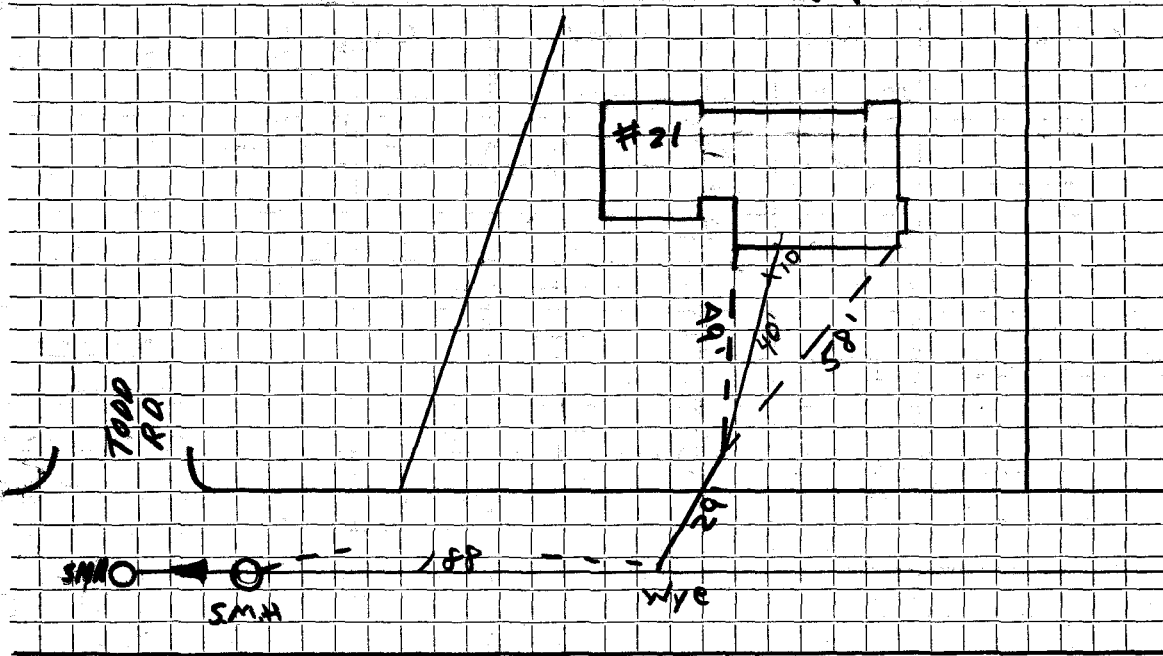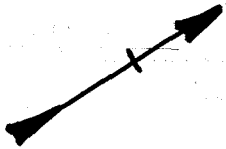

Connection made in Street. Work completed

Remarks:
.....
.....