


DATE _____

TOWN OF LEXINGTON — BOARD OF PUBLIC WORKS

SEWER DIVISION

Sketch of Service Here **22**

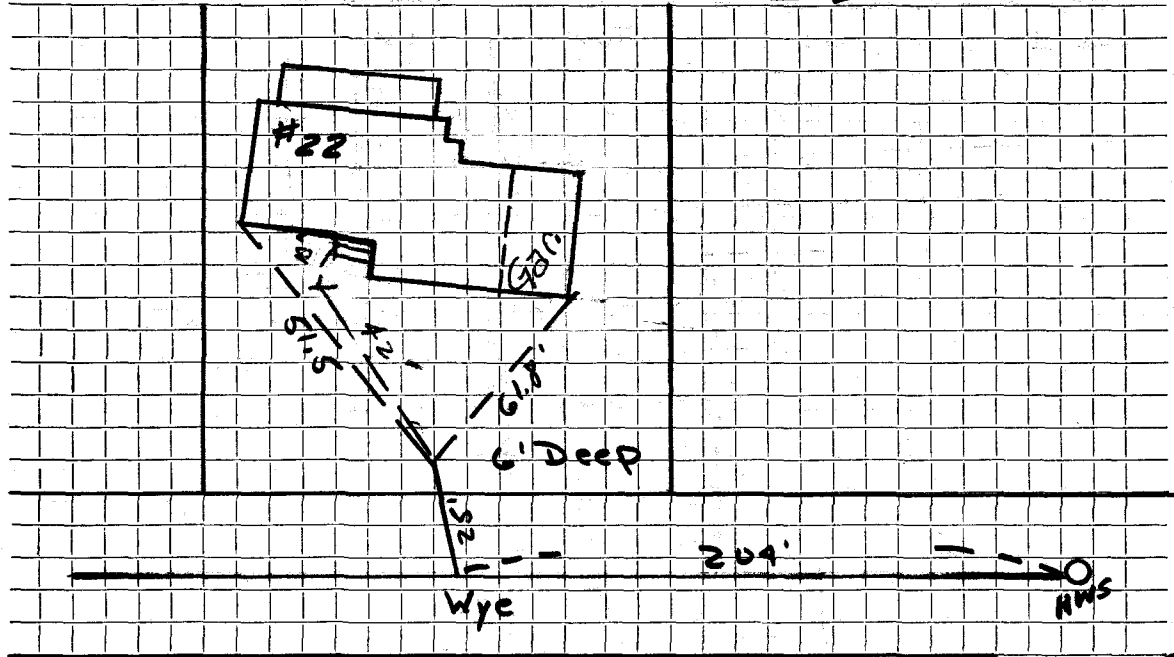

Connection made in ... SADDLE CROB. RD. Street.

Work completed ... 700 RD

25 APRIL 1974

Remarks:

.....

.....