

Name Moore Homes Inc.

Service No.

Address 27 Saddle Club Road

27 Saddle Club Road

Location Lot 12

Kind of Pipe

Size

Size of Main

Repair—Renewal—New Service DeFlice #1466

Location


Date		Material	Amount	Total	Date		Amount
10-8-69	42'	6" Transite pipe					
	10'	4" Cast Iron pipe					

DATE _____

TOWN OF LEXINGTON — BOARD OF PUBLIC WORKS

SEWER DIVISION

Sketch of Service Here **27**

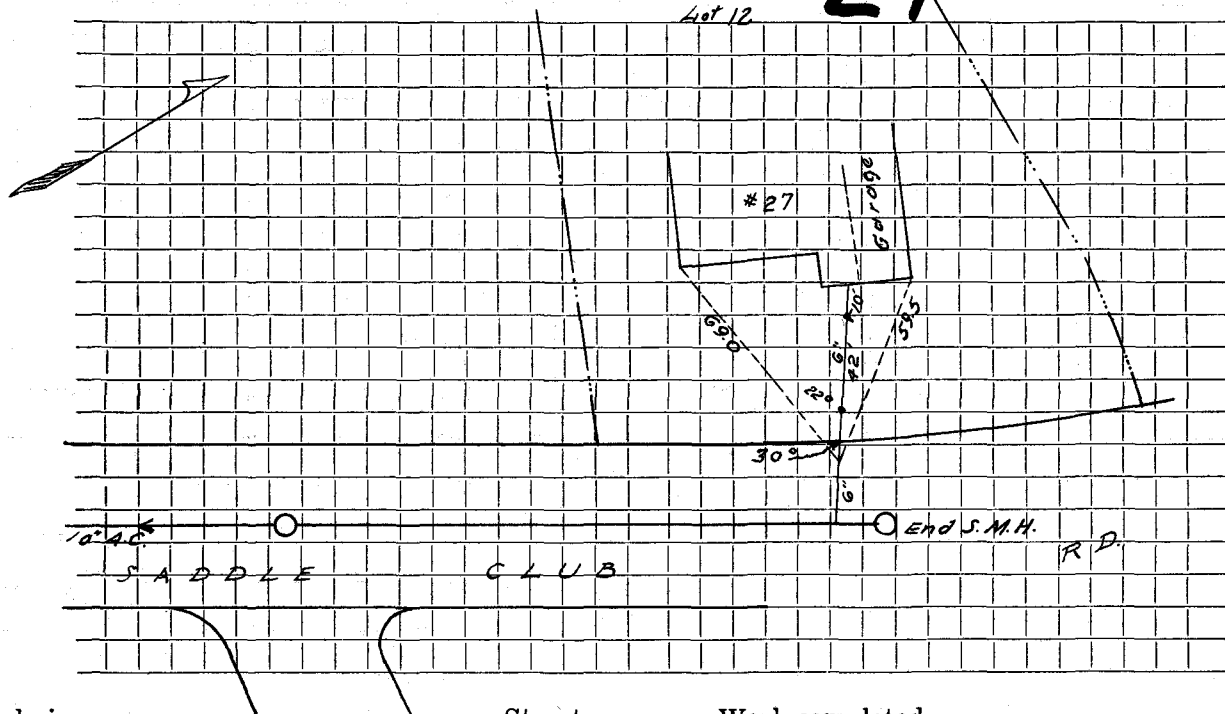

Connection made in Street. Work completed

Remarks:
.....
.....