




DATE \_\_\_\_\_

# TOWN OF LEXINGTON — BOARD OF PUBLIC WORKS

## SEWER DIVISION

Sketch of Service Here **35**

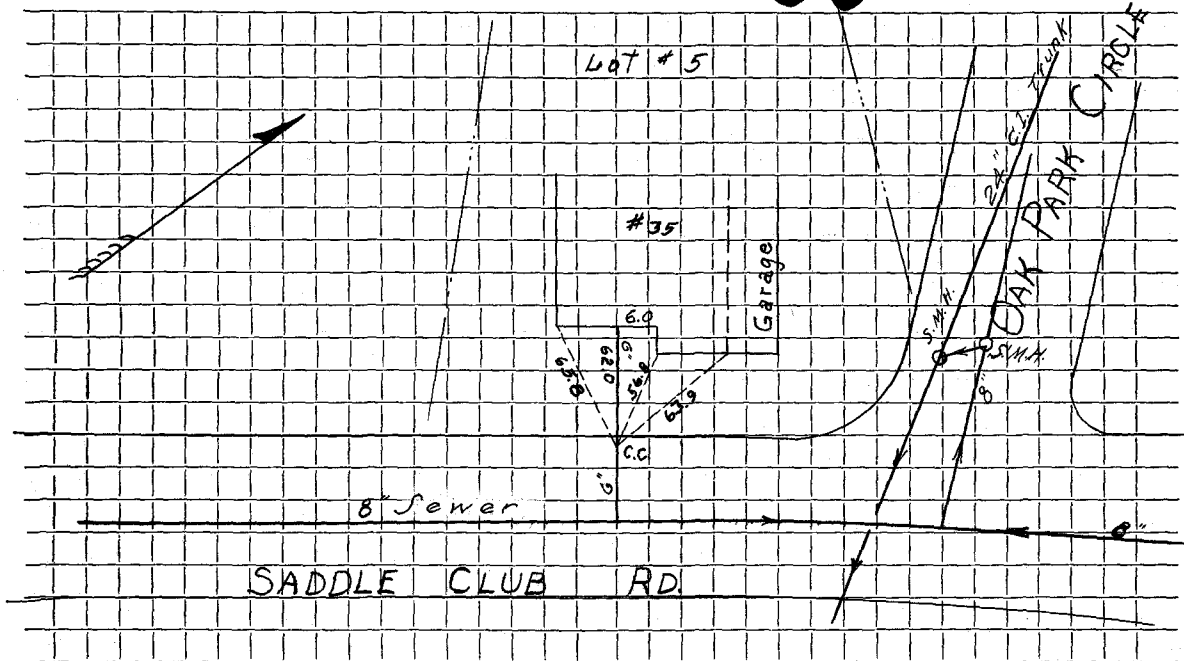

Connection made in ..... Street. Work completed .....

Remarks: .....

.....

.....