

Name Oak Park Corp.

Service No.

Address 37 Saddle Club Road

37 Saddle Club Road

Location

Kind of Pipe

Size

Size of Main

~~Repair - Renewal~~ **New Service** J.M.Lucente Permit #A98

Location


Date		Material	Amount		Total		Date		Amount	
5/16/66	79'	6" Transite pipe								

DATE _____

TOWN OF LEXINGTON — BOARD OF PUBLIC WORKS
SEWER DIVISION

Sketch of Service Here

37

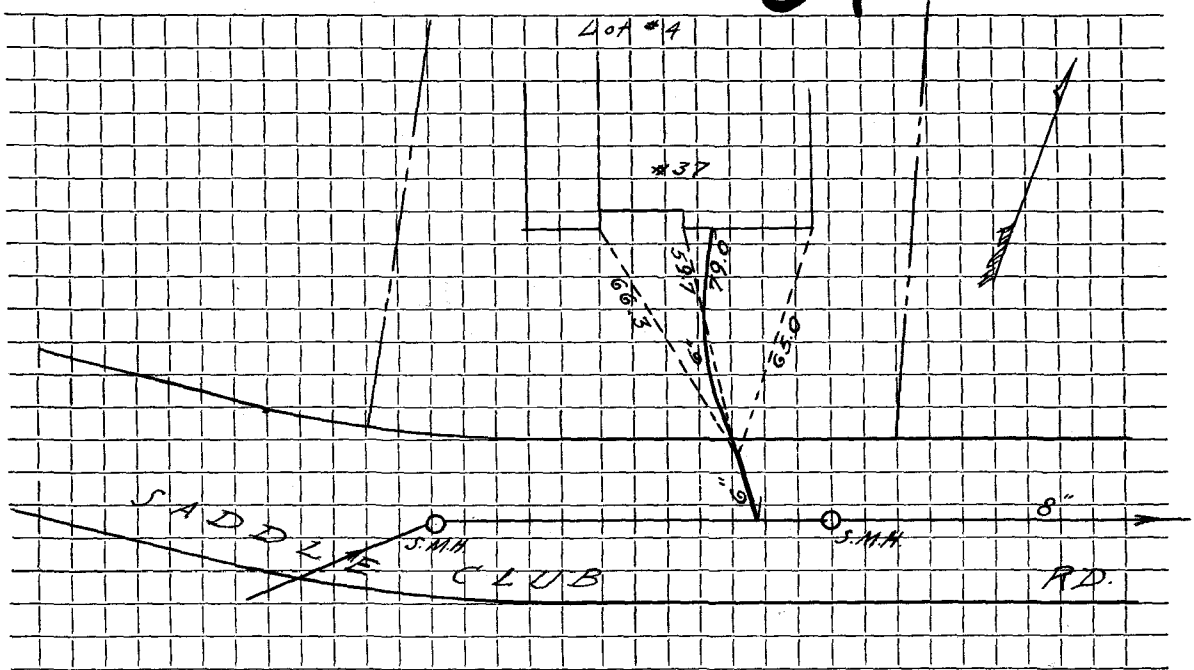

Connection made in Street. Work completed

Remarks:
.....
.....