

Name Oak Park Corp.

Service No.

Address 38 Saddle Club Road

Lot 18 38 Saddle Club Road Location

Kind of Pipe

Size

Size of Main

Repair—Renewal—New Service Lucente #1897


Location

Date		Material	Amount		Total		Date		Amount	
8-23-71	47'	6" Transite pipe								
	10'	4" CI								

DATE _____

TOWN OF LEXINGTON — BOARD OF PUBLIC WORKS
SEWER DIVISION

Sketch of Service Here **38**

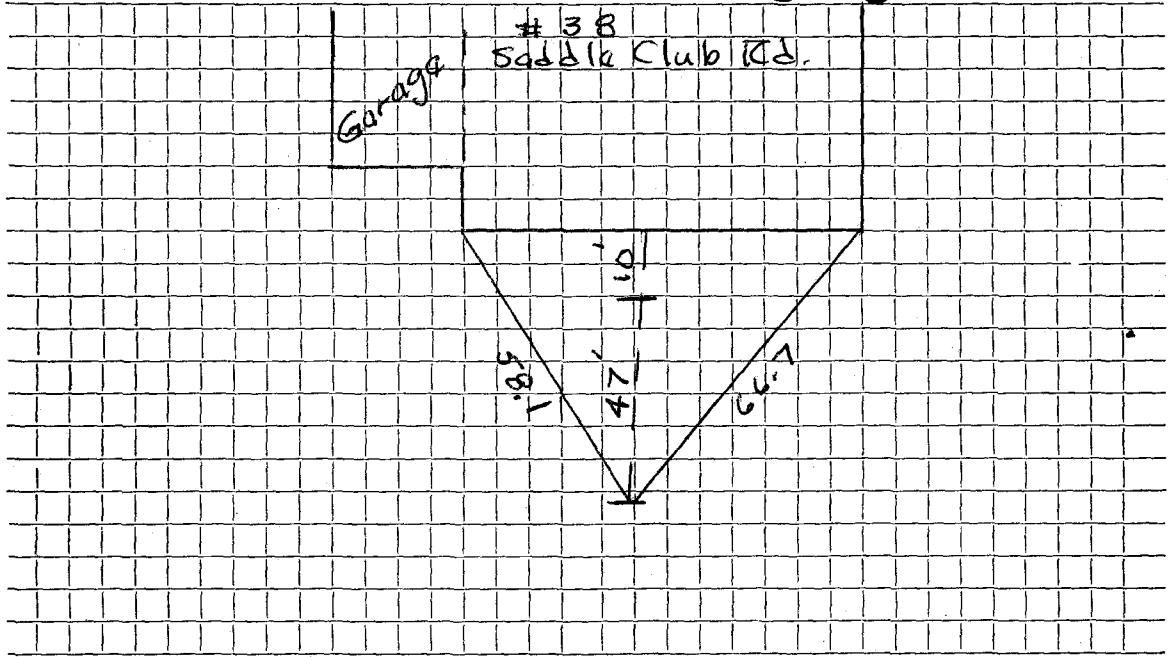

Connection made in Street. Work completed

Remarks:
.....
.....