

Name Richard Biederman

Service No. 69

Address 1 SADDLE CLUB RD.

Location

Kind of Pipe A.C.

Size 6"

Size of Main 10"

Repair—Renewal—New Service

Valeri Const. #2327

Location NOV 19 1973

Date		Material	Amount	Total	Date		Amount
7/9/73		21'-6" A.C. @ \$8.90	\$186.90		7-23-73	Deposit	186.90
7/24/73	126'	6" Transite pipe					


U.B.M.18501

DATE _____

TOWN OF LEXINGTON — BOARD OF PUBLIC WORKS
SEWER DIVISION

Sketch of Service Here

4

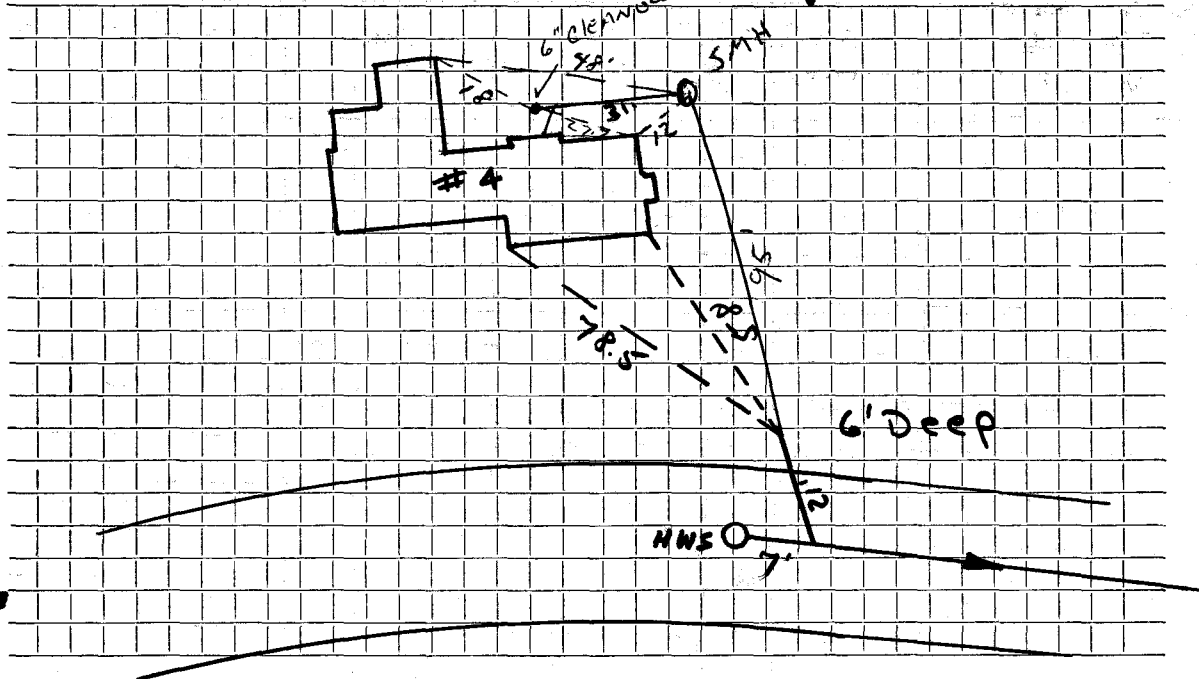

Connection made in Street. Work completed

Remarks:
.....
.....