


DATE 11/23/22

TOWN OF LEXINGTON — BOARD OF PUBLIC WORKS
SEWER DIVISION

Sketch of Service Here

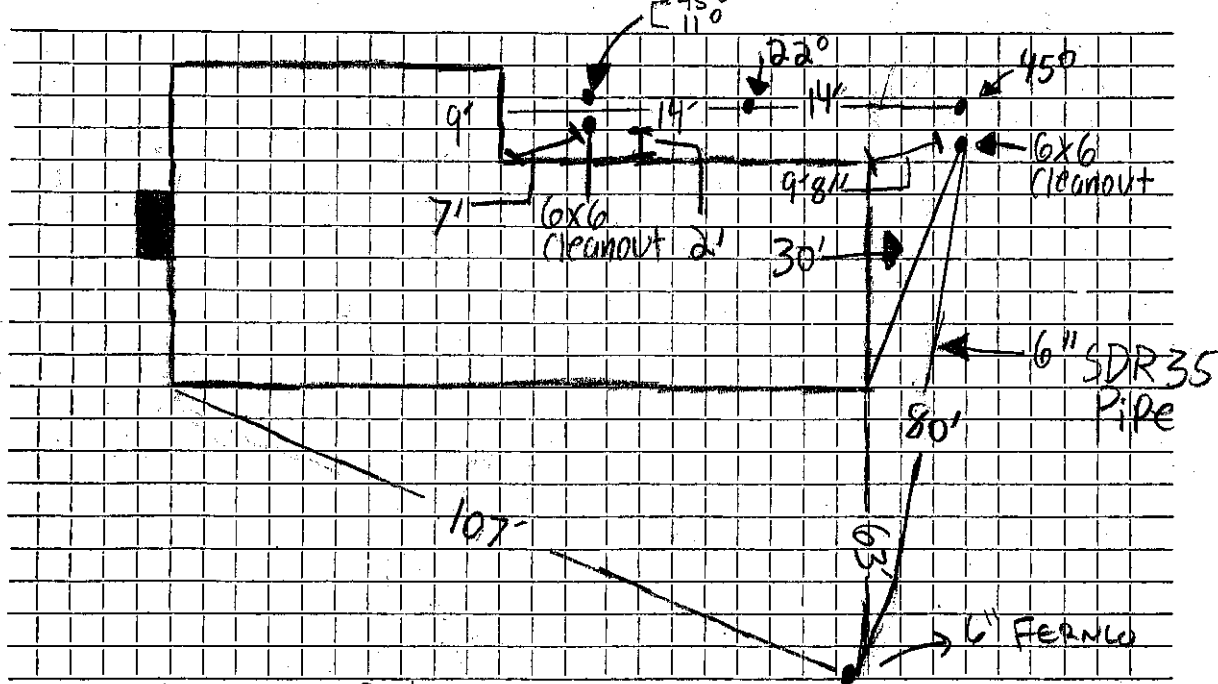

Connection made in 6 Saddle Club Rd Street. Work completed DAVID SANTO

Remarks: