




DATE 7/2018

TOWN OF LEXINGTON — BOARD OF PUBLIC WORKS

SEWER DIVISION

Sketch of Service Here

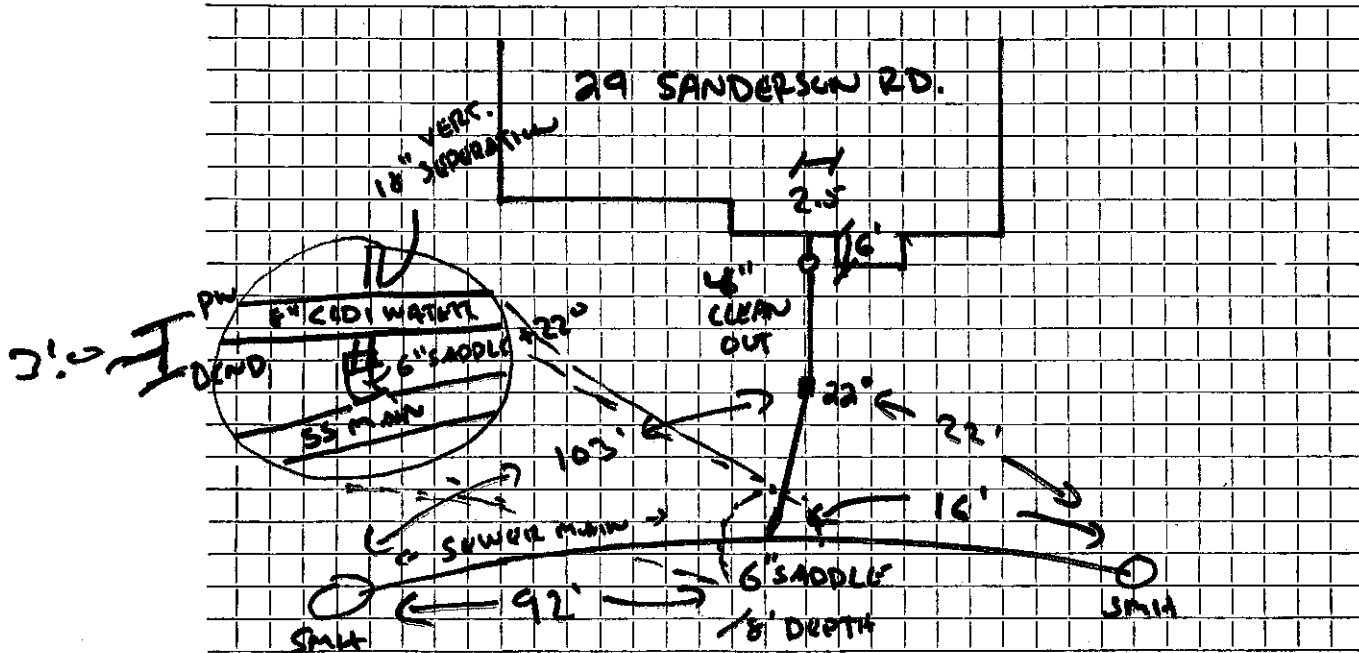

Connection made in SANDERSON Street. Work completed JOE HANICINS

Remarks: