




DATE \_\_\_\_\_

**TOWN OF LEXINGTON — BOARD OF PUBLIC WORKS**  
**SEWER DIVISION**

Sketch of Service Here **10**  
LOT 7

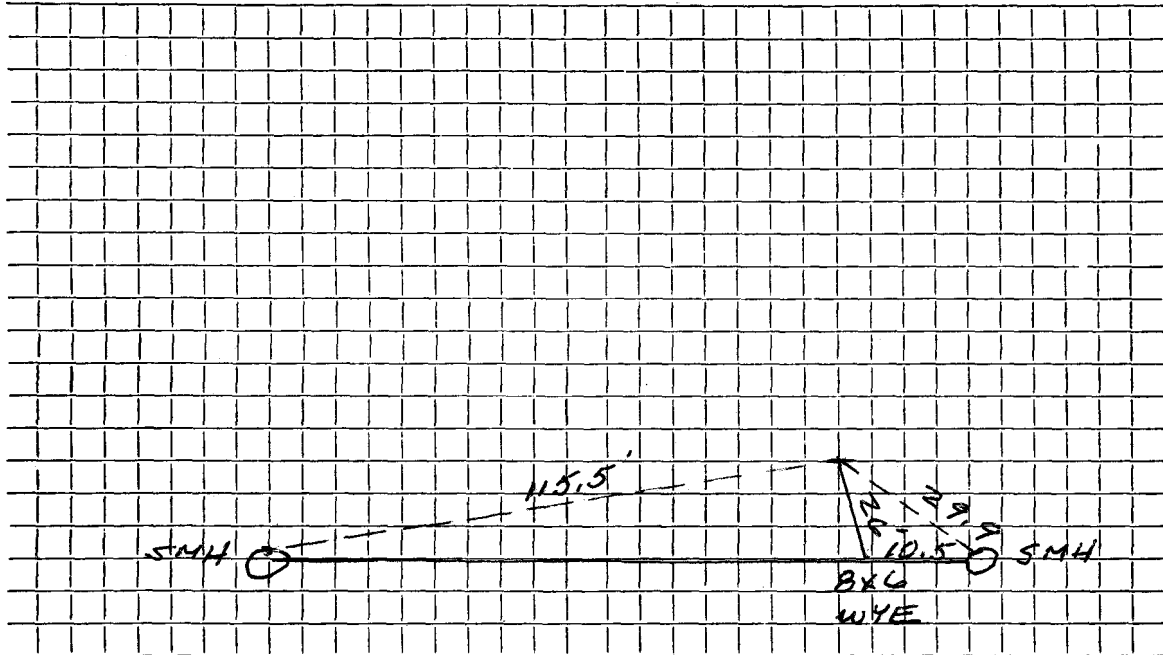

Connection made in SANDERSON RD. Street. Work completed .....

Remarks: .....  
.....  
.....