




DATE \_\_\_\_\_

TOWN OF LEXINGTON — BOARD OF PUBLIC WORKS  
SEWER DIVISION

Sketch of Service Here **//**

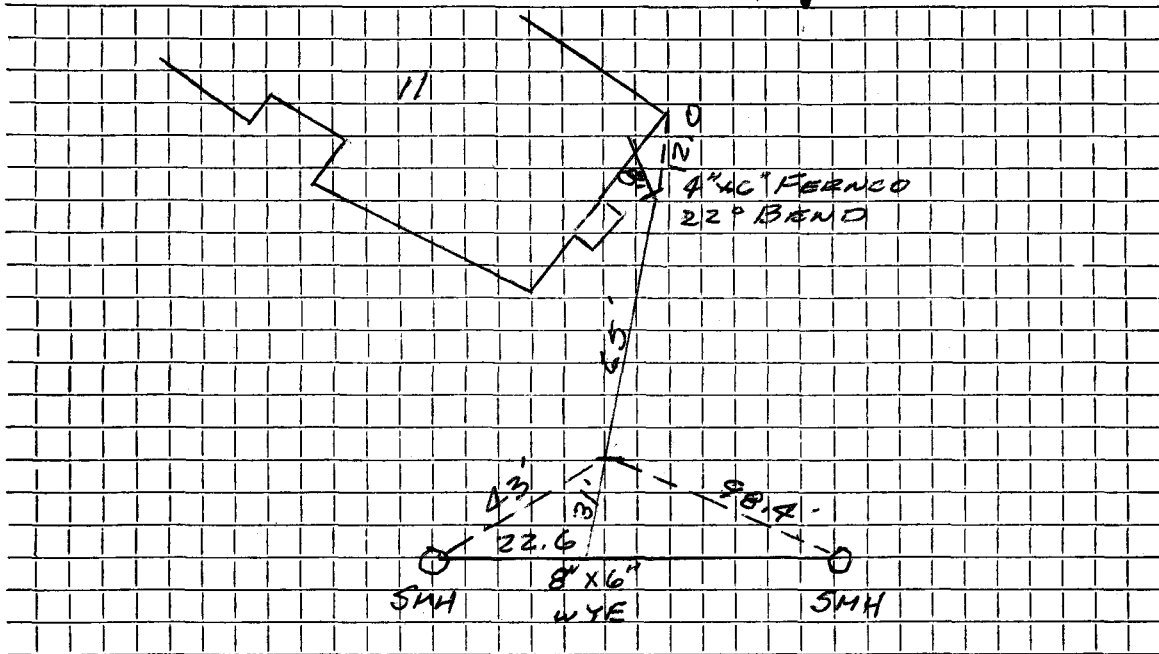

Connection made in SANDERSON RD. Street. Work completed .....

Remarks: .....  
.....  
.....