


DATE _____

TOWN OF LEXINGTON — BOARD OF PUBLIC WORKS
SEWER DIVISION

Sketch of Service Here **14**
LOT 9

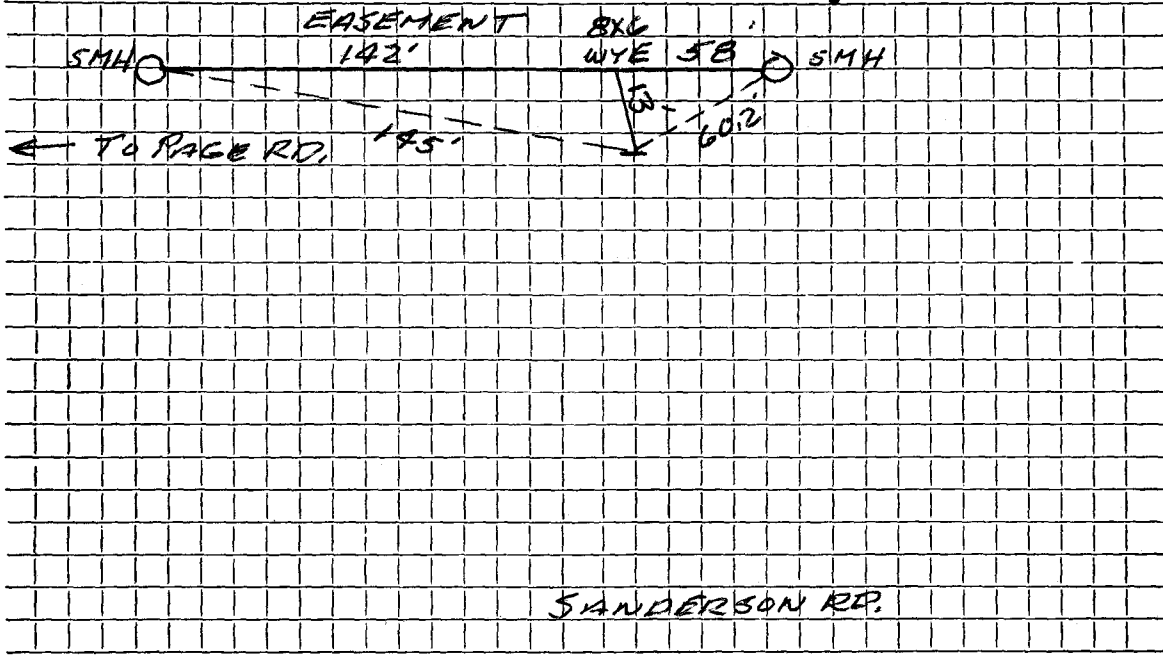

Connection made in EASEMENT Street. Work completed

Remarks:
.....
.....