

Name Frank DiRocco

Service No.

Address 18 Sanderson Road

18 Sanderson Road

Location

Kind of Pipe

Size 6"

Size of Main 8"

~~EXPANDED~~ - New Service Valeri #831
R.A. Buccella - Permit #131

Location

Date	Material	Amount	Total	Date	Amount
10-31-64	24' 6" Transite pipe				
10-11-67	72' 6" Transite pipe				
	10' 4" Cast Iron pipe				


DATE _____

TOWN OF LEXINGTON — BOARD OF PUBLIC WORKS

SEWER DIVISION

Sketch of Service Here

18

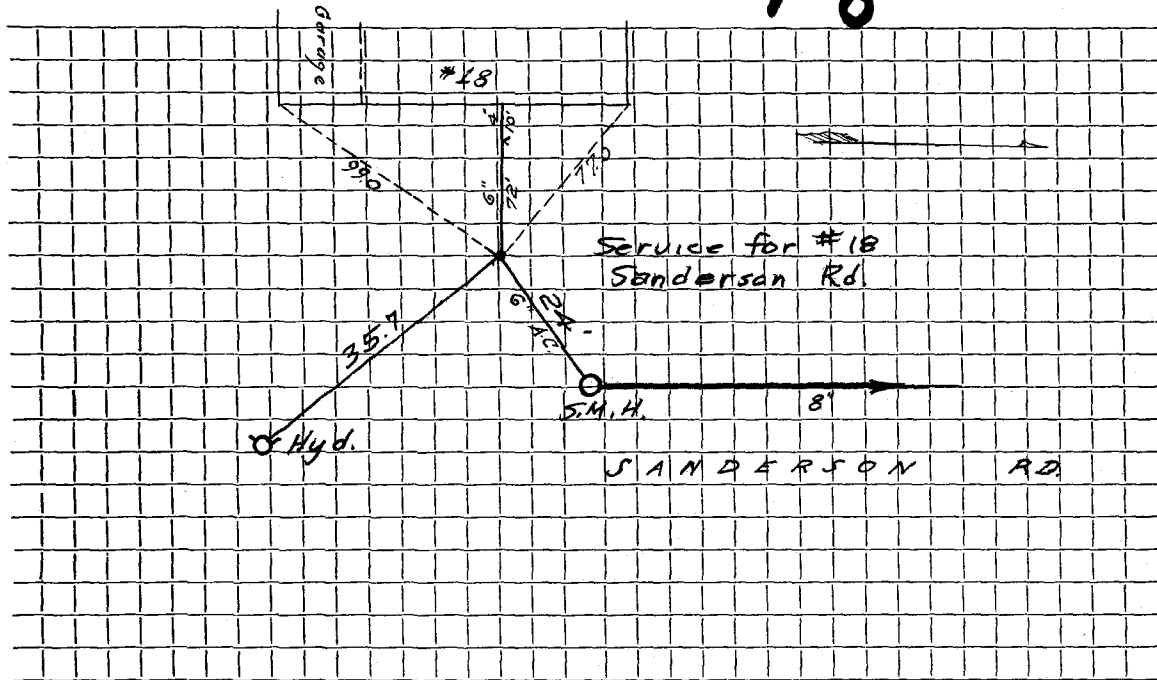

Connection made in Street. Work completed

Remarks:
.....
.....