

Name

Service No.

Address

C SANDERSON RD

2 Sanderson Road

Location

Kind of Pipe

Size 6"

Size of Main 8"

Repair—Renewal—New Service

NEW SERVICE

Location

Date

Material

Amount

Total

Date

Amount


11/21 94 48' of 6" PVC

5-16-88
26' 6" P.V.C.
1 6" X 8" Wye

DATE 11/21/94

TOWN OF LEXINGTON — BOARD OF PUBLIC WORKS
SEWER DIVISION

Sketch of Service Here **2**

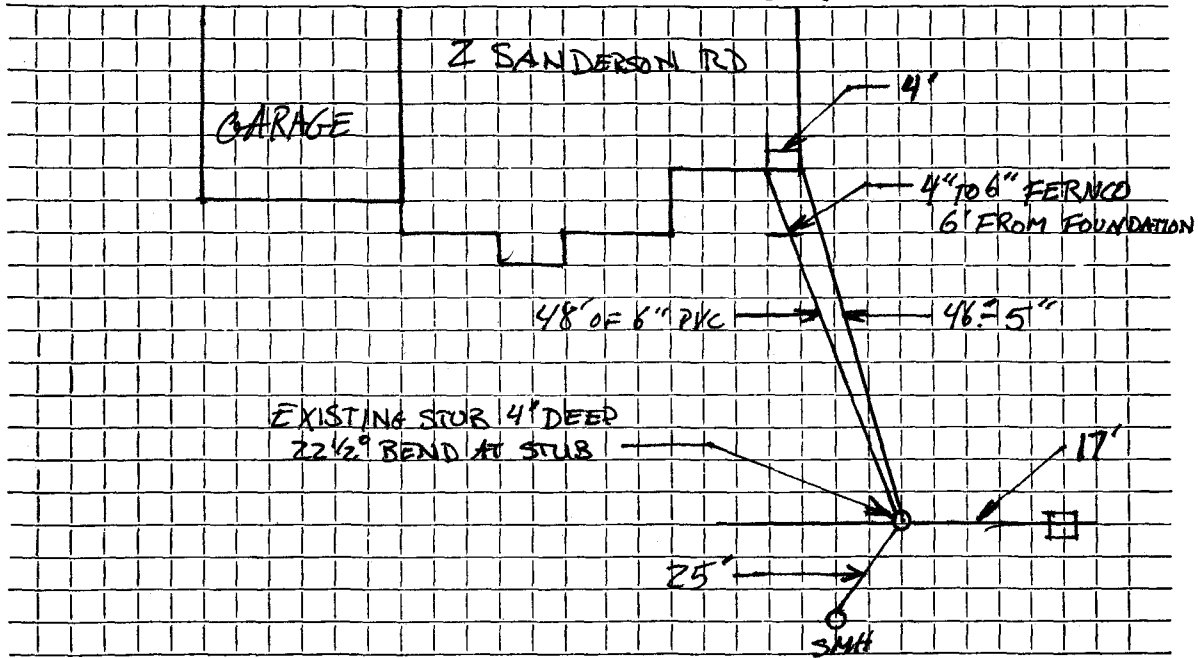

Connection made in Street. Work completed

Remarks:
.....
.....