


DATE _____

TOWN OF LEXINGTON — BOARD OF PUBLIC WORKS
SEWER DIVISION

Sketch of Service Here

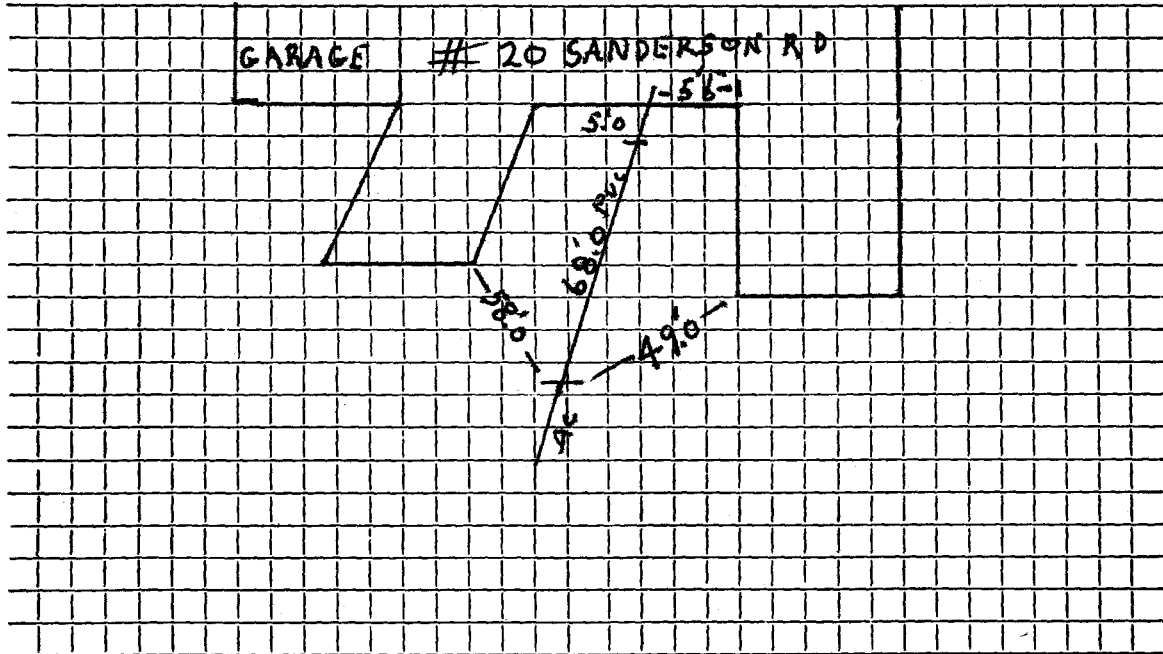

Connection made in Street.

Work completed 5/25/06 J. McLaughlin.....

Remarks:

.....

.....