

Name West Chester Estates

Service No. 208

Address 21 Sanderson Road

21 Sanderson Road

Location

Kind of Pipe

Size 6"

Size of Main 8"

~~Repair~~ ~~Renewal~~ — New Service

Location *Can. 11/21/60*


Date	Material	Amount	Total	Date	Amount
0-2-59	Labor	8 07		10-2-60	Deposit 20 00
	10% O. H.	81	8 88	11-21-60 *	Refund 9 25
	OWNER INSTALLED				4 25
	LABOR FOR INSTALLATION				
10-14-60	Labor	7 43			
	10% O.H.	74	8 17		
	45' 6" Transite pipe @.78		35 10		
	1 11 1/2" Transite Bend		5 10		
	1 Hr. Trucking @3.00		3 00		
			60 25		
					* Applied to WCh # 203

DATE _____

TOWN OF LEXINGTON — BOARD OF PUBLIC WORKS

SEWER DIVISION

Sketch of Service Here

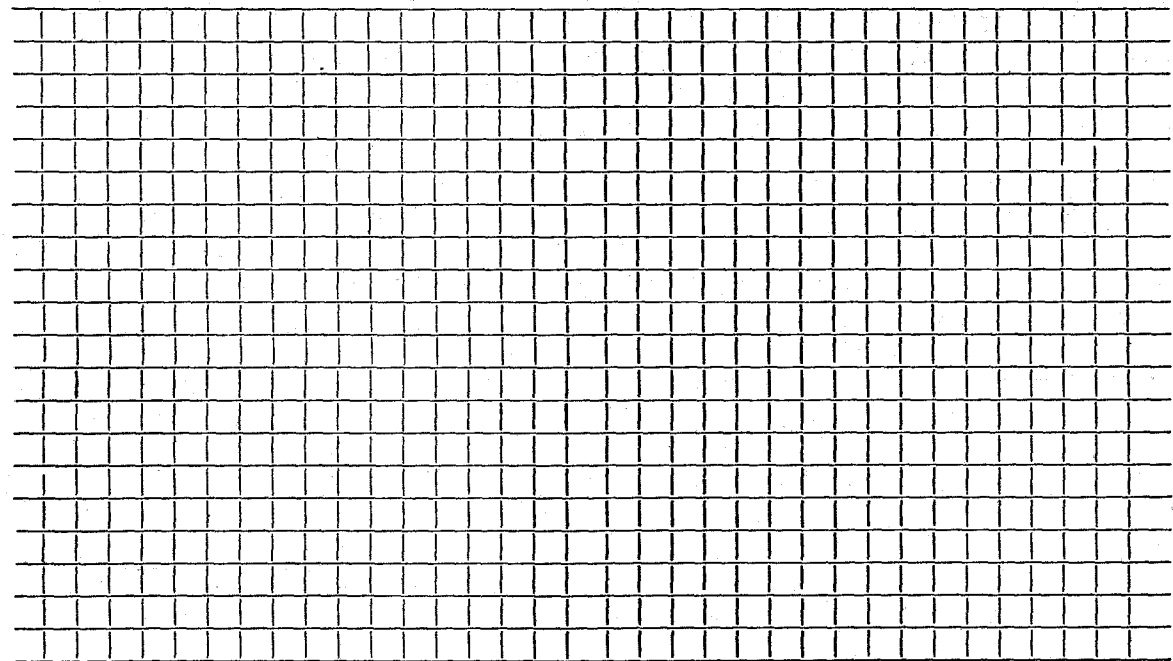

Connection made in Street. Work completed :

Remarks:
.....
.....