




DATE \_\_\_\_\_

TOWN OF LEXINGTON — BOARD OF PUBLIC WORKS

SEWER DIVISION

Sketch of Service Here

3

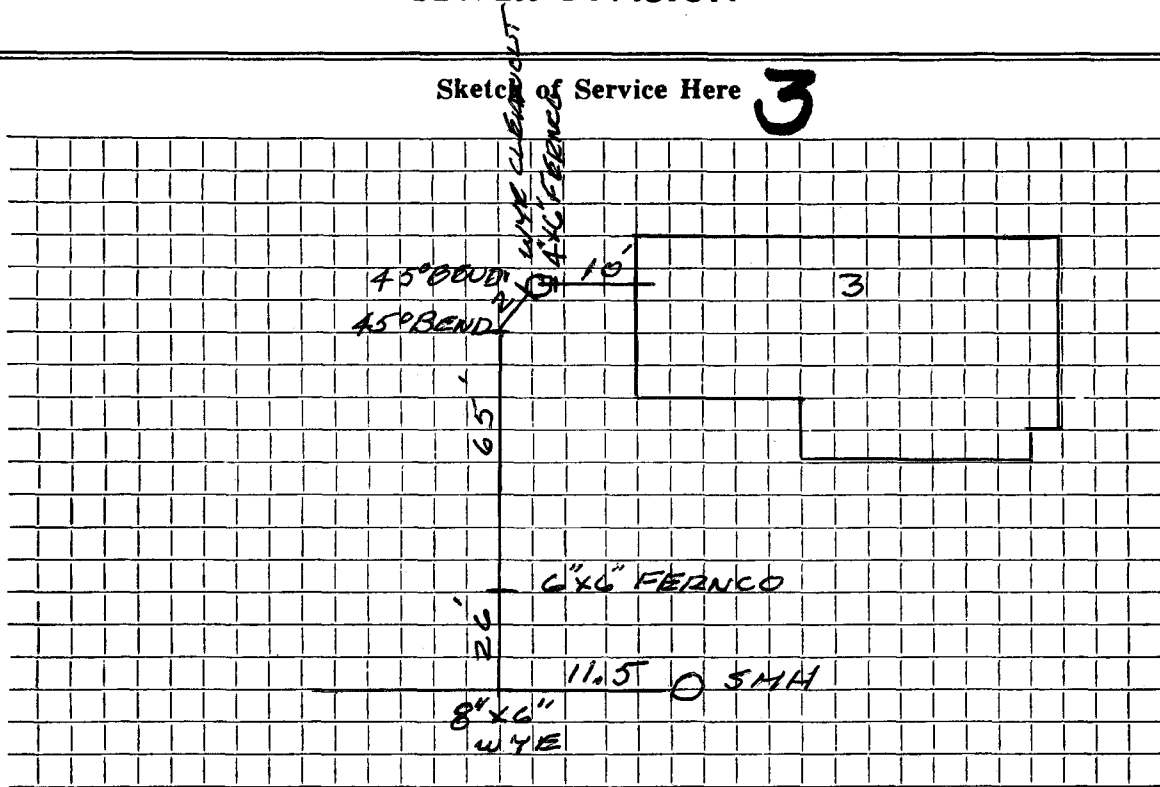

Connection made in SANDERSON RD. Street. Work completed .....

Remarks: 3 SANDERSON FORMERLY 194 LOWELL ST.  
(CASELLI)