

Name

Service No.

Address 30 Sanderson Rd

Location

Kind of Pipe 6" SDR 35 PVC

Size 6"

Size of Main

Repair ~~Renewal~~ New Service to main

Location

Date	Material	Amount	Total	Date		Amount
------	----------	--------	-------	------	--	--------

11/15/21

6" Cleanout

6" - 22 1/2° bend


6" SDR 35 PVC

Insert a tee

TOWN OF LEXINGTON — BOARD OF PUBLIC WORKS

SEWER DIVISION

Sketch of Service Here

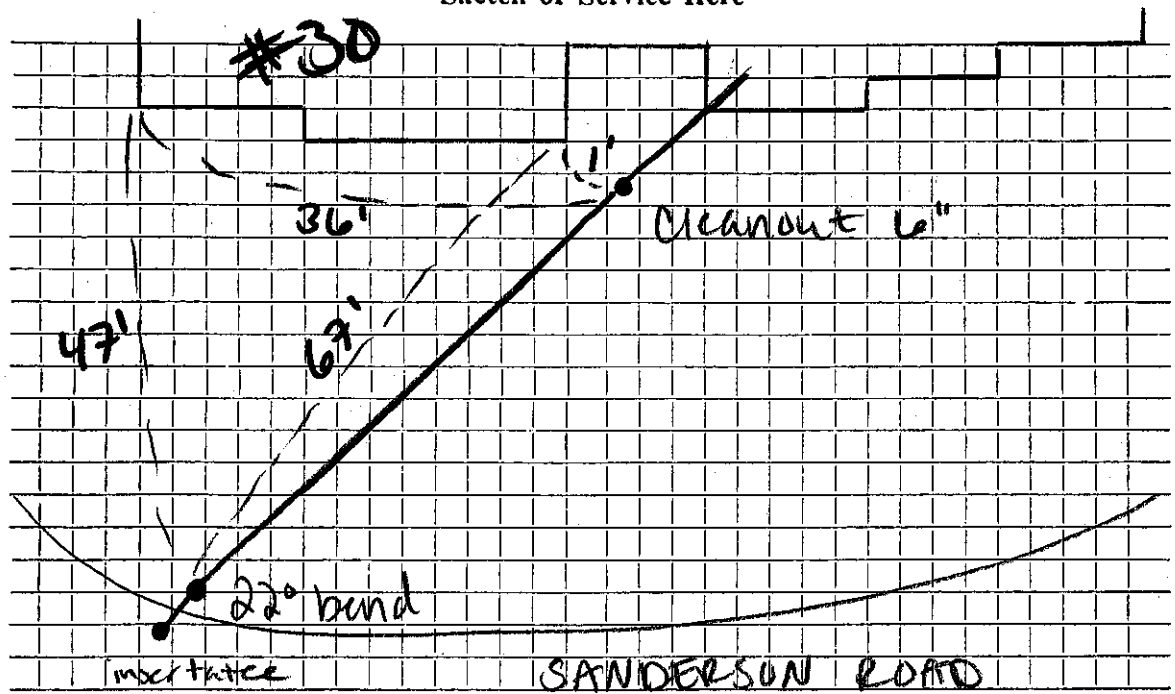

Connection made in ... SANDERSON ROAD Street.

Work completed

Remarks: