

Name *Megan Shadley*

Service No.

Address *31 Sanderson Road*

Contractors: *Bradley Co, & Rotondi*

Location *Lexington MA*

Kind of Pipe

Size

Size of Main

Repair—Renewal—New Service

Location

Date

Material

Amount

Total

Date

Amount

1/14/19


6" x 6" Feraco

1

DATE June 2017

TOWN OF LEXINGTON — BOARD OF PUBLIC WORKS
SEWER DIVISION

Sketch of Service Here

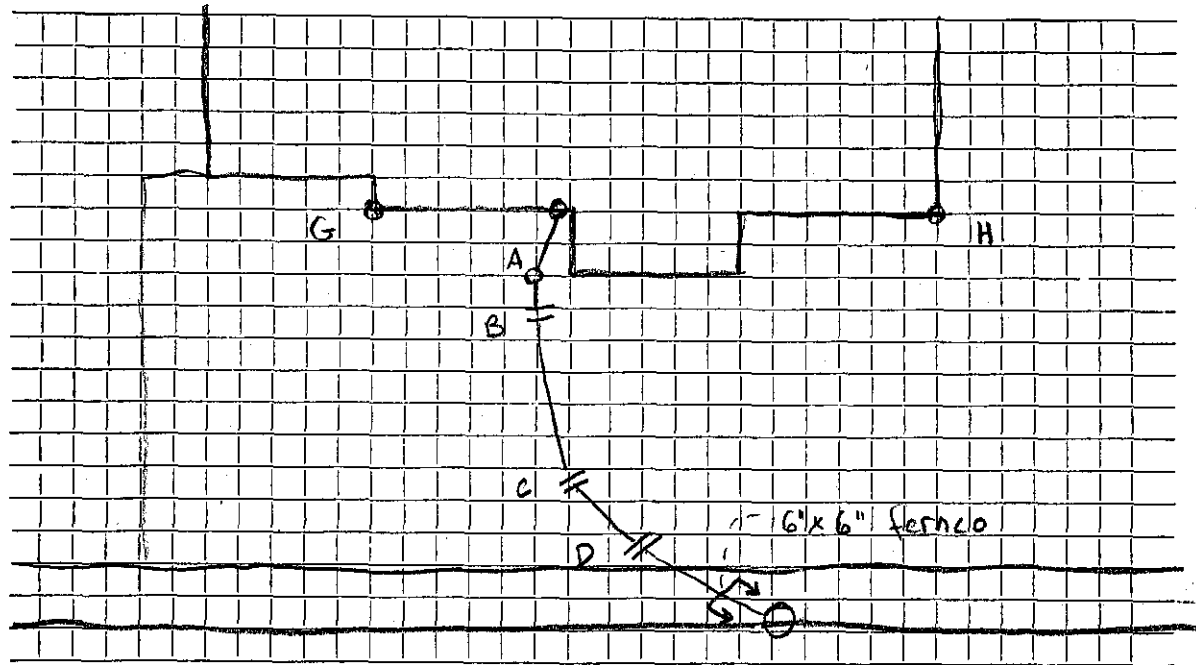

- GA 12'
- GB 14.4'
- GC 35'
- GD 39.2'
- HB 25.8'
- HC 36.6'
- HD 40.8'

Ferroc → SMH
= 12'

Connection made in 31 Sanderson Road Street. Work completed

Remarks: Bradley Co. did work until D. Rotondi did work connecting to main.