


DATE _____

TOWN OF LEXINGTON — BOARD OF PUBLIC WORKS
SEWER DIVISION

Sketch of Service Here **33**

33 Sanderson Road
Lot # 17

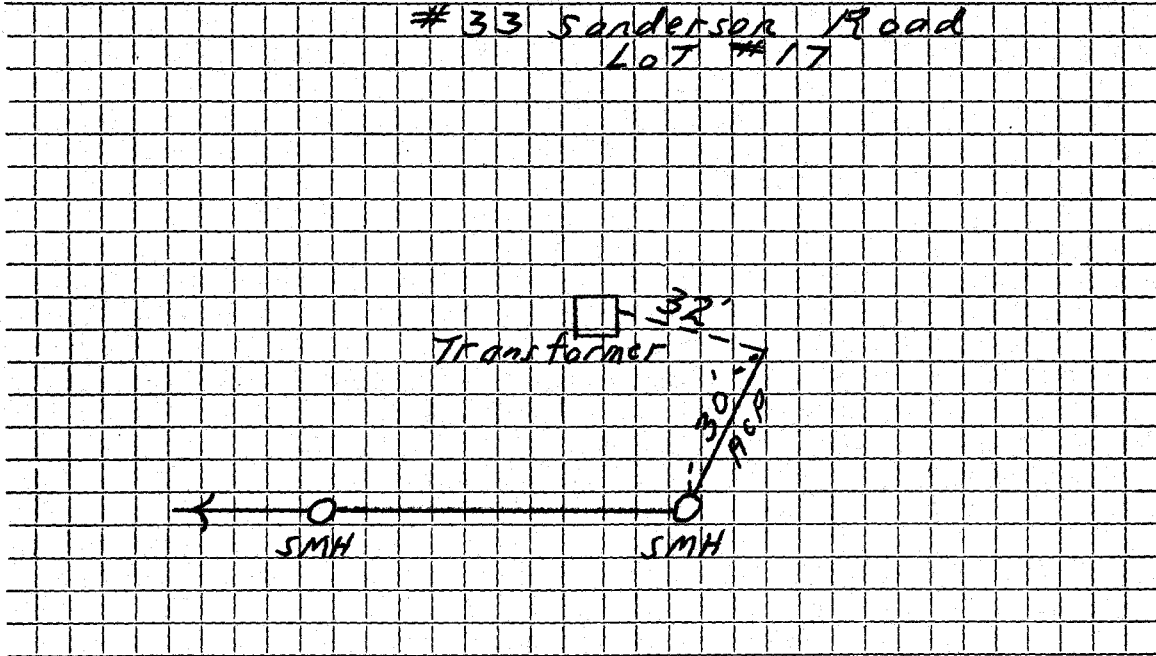

Connection made in Sanderson Road ~~Street~~ Work completed

Remarks:
.....
.....