

Name

Service No.

Address # 35 Sanderson Road

35 Sanderson Road

Kind of Pipe

Size 6"

Repair—Renewal—New Service

Location

Size of Main 8"

Location

Date	Material	Amount	Total	Date	Amount
5/10	76' 20"- 6" P.C.P.				
5/10	76' 30"- 6" P.C.P.				
	10' - 4" C.I.				


DATE _____

TOWN OF LEXINGTON — BOARD OF PUBLIC WORKS

SEWER DIVISION

Sketch of Service Here

35

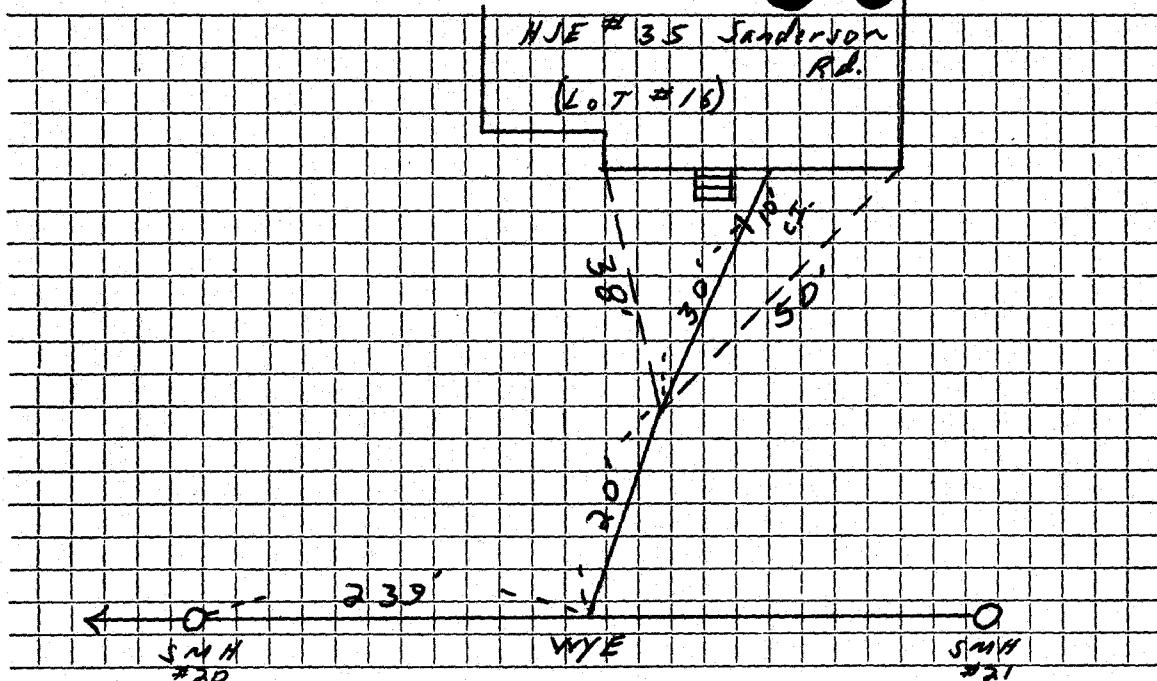

Connection made in Sanderson Read Street. Work completed

Remarks: