

Name

Service No.

Address #37 Sanderson Road

37 SANDERSON ROAD

Location

Kind of Pipe

Size 6"

Size of Main 8"

Repair—Renewal—New Service


Location

Date	Material	Amount	Total	Date	Amount
5/20	76 30' - 6" A.C.P.				
6/17	76 30' - 6" A.C.P.				
	10' - 9" C.I.				

DATE _____

TOWN OF LEXINGTON — BOARD OF PUBLIC WORKS
SEWER DIVISION

Sketch of Service Here **37**

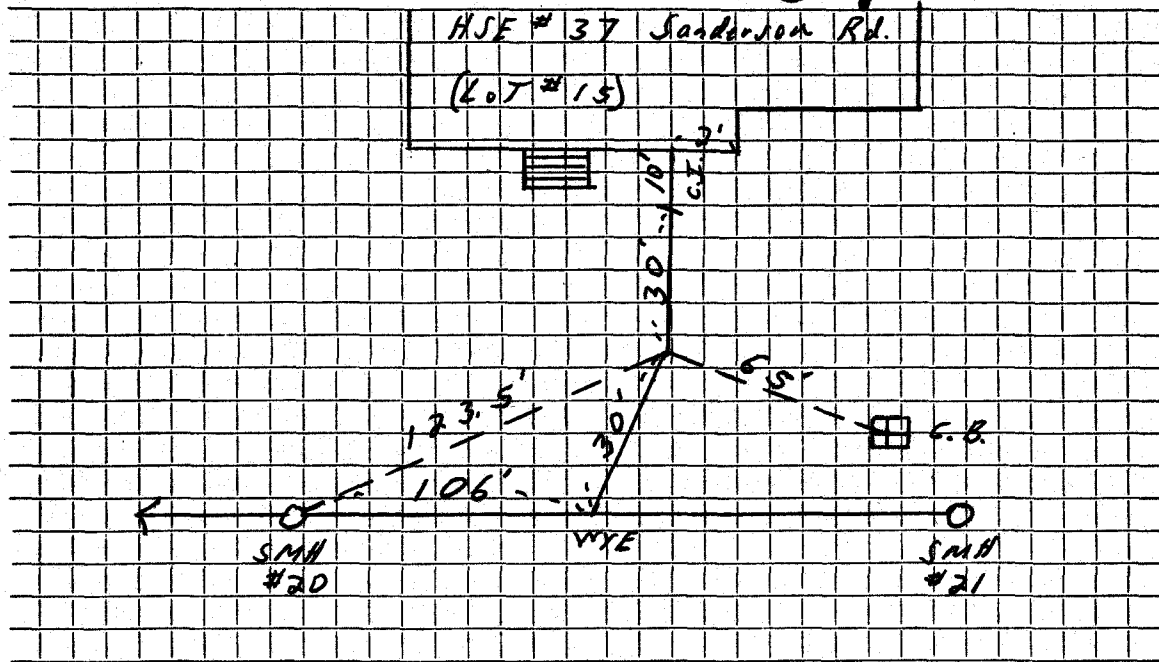

Connection made in Sanderson Road Street. Work completed

Remarks:
.....
.....