

Service No.

Name

Address 38 Sanderson Road

Location

38 Sanderson Road

Kind of Pipe

Size 6"

Size of Main 8"

Repair—Renewal—New Service

Location


Date	Material	Amount	Total	Date	Amount
5/20 76	30'- 6" A.C.P.				

DATE _____

TOWN OF LEXINGTON — BOARD OF PUBLIC WORKS
SEWER DIVISION

Sketch of Service Here

38

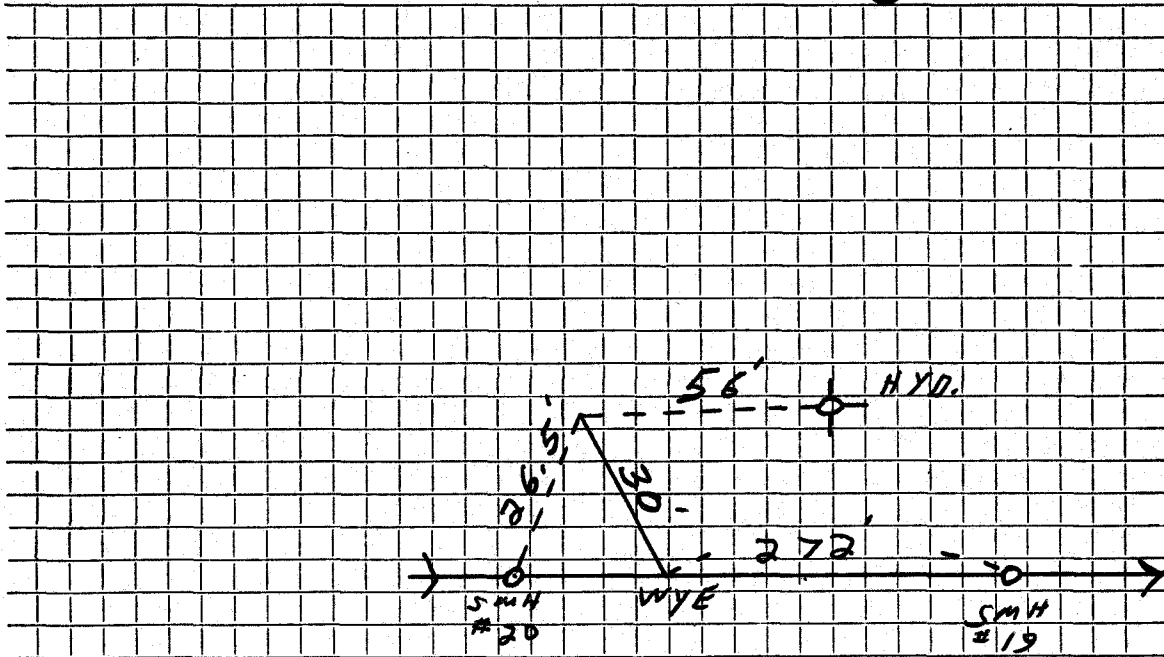

Connection made in Street. Work completed

Remarks:
.....
.....