

Service No.

Name

Address 40 Sanderson Road

Location

40 Sanderson Road

Size of Main 8"

Size 6"

Location

Repair—Renewal—New Service

Date	Material	Amount	Total	Date	Amount
5-25 76	20' = 6" R.C.P.				


C.P.M. 3880

DATE _____

TOWN OF LEXINGTON — BOARD OF PUBLIC WORKS

SEWER DIVISION

Sketch of Service Here
40 Sanderson Road 40
Lot # 7

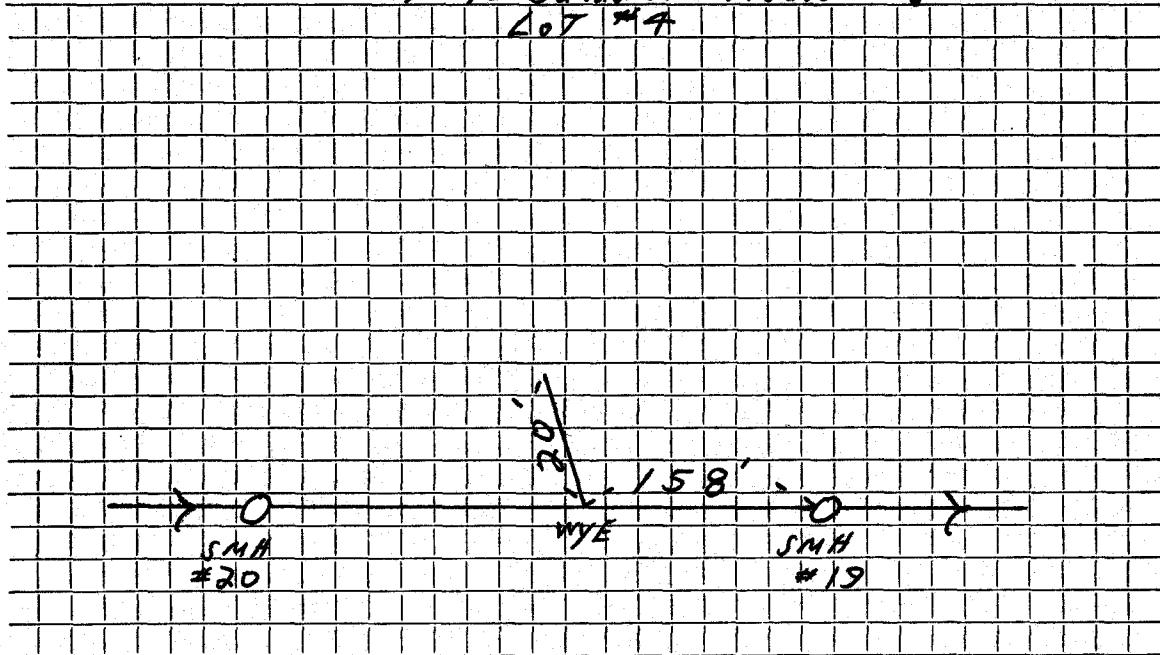

Connection made in Street. Work completed

Remarks:
.....
.....