




DATE \_\_\_\_\_

TOWN OF LEXINGTON — BOARD OF PUBLIC WORKS  
SEWER DIVISION

Sketch of Service Here

41

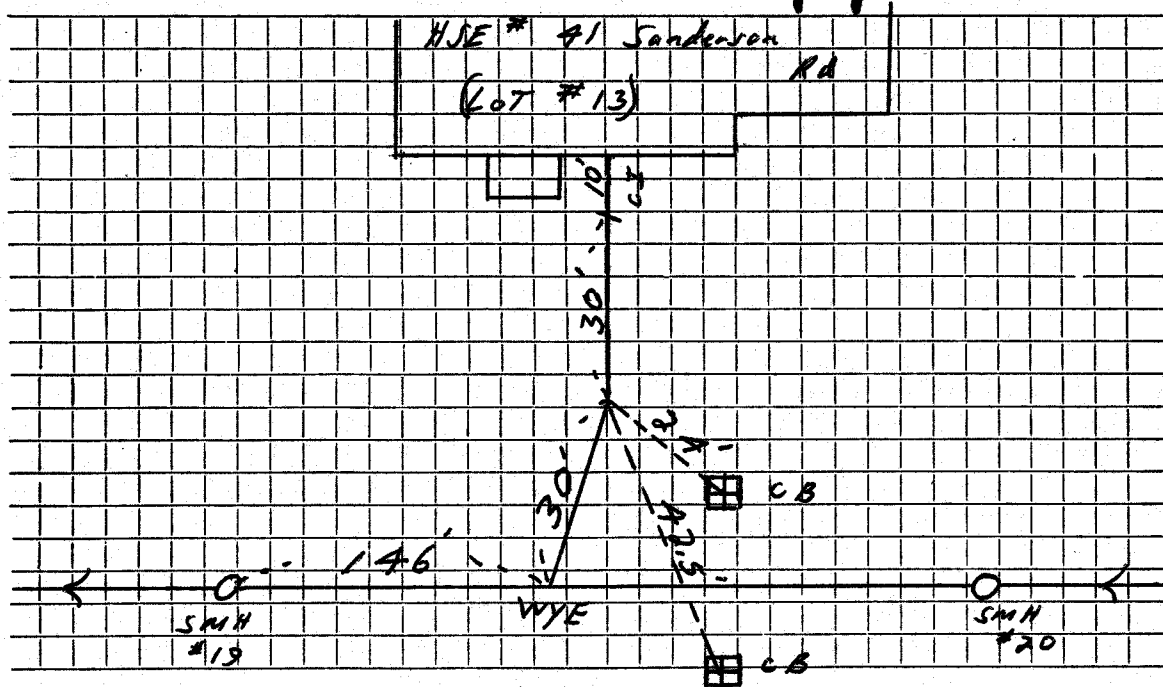

Connection made in Sanderson Road Street. Work completed .....

Remarks: .....